


Details of survey on opposite page

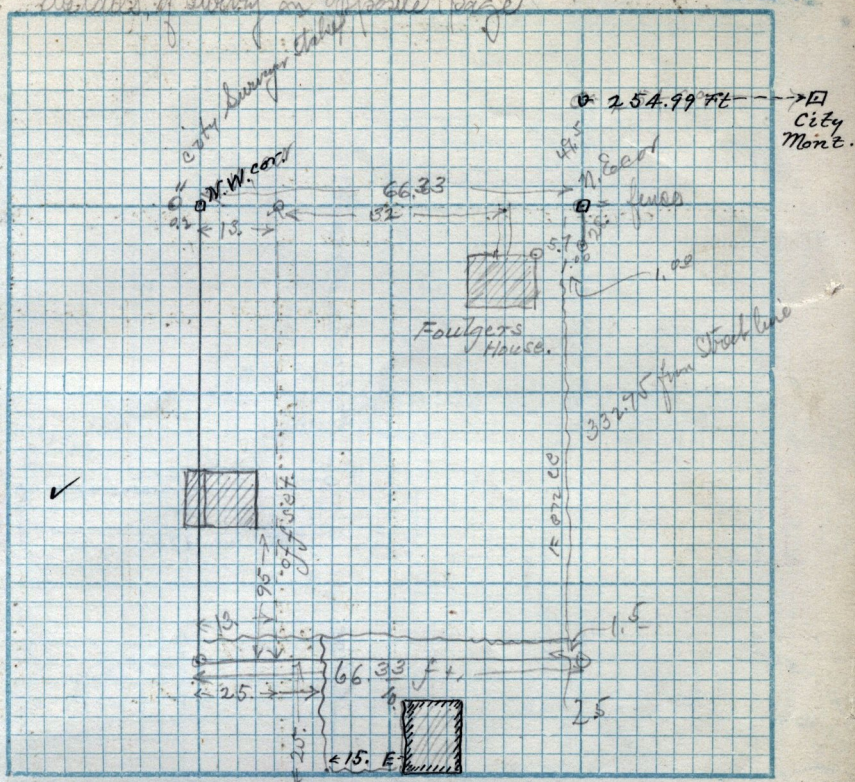

Scale: Chains per inch.