SEE Book F page 377

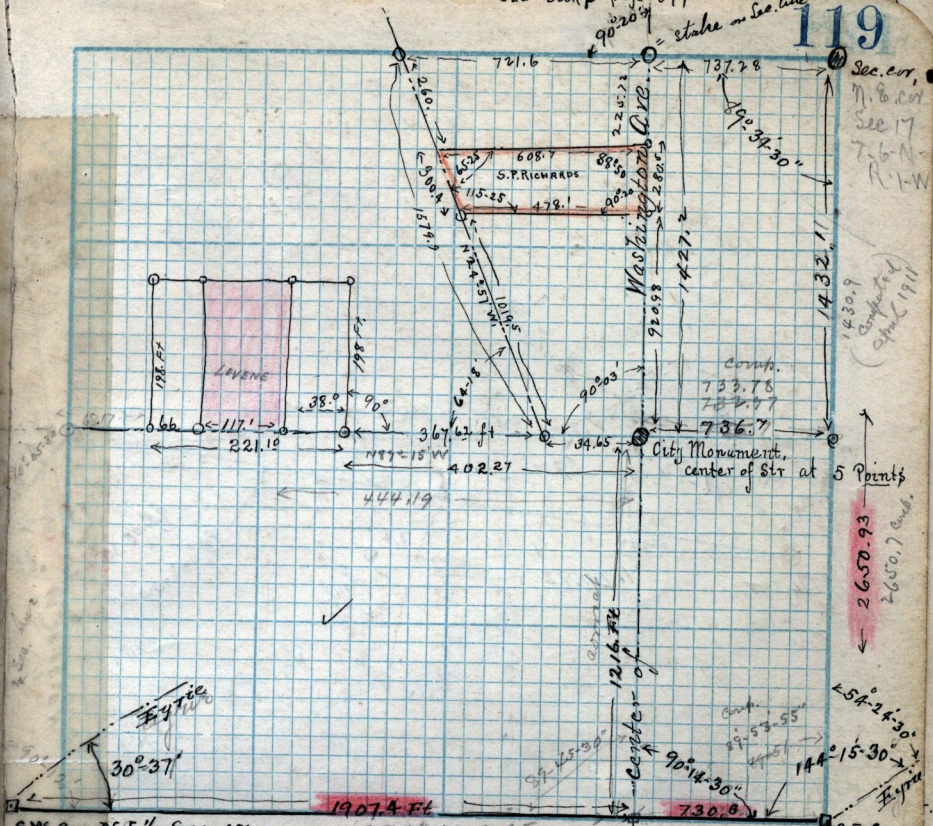

Scale: ..... Chains per inch.

For tie points to this mine
See Book H, page 85.

Survey made for Wm Coleman, April -1890,

G. White, transit.

6-552. Milo M. Levens to James Coleman,
Pt N. E 1/4 Sec 17. T. 6. N. R. 1. W. Beg. 18.48 ch N.
& 19.61 ch West from the S.E. cor. of said 1/4 Sec.
thence North 3. ch, E 117.10 ft, S 3.00 ch, W 117.10
ft to beg.

— to here —