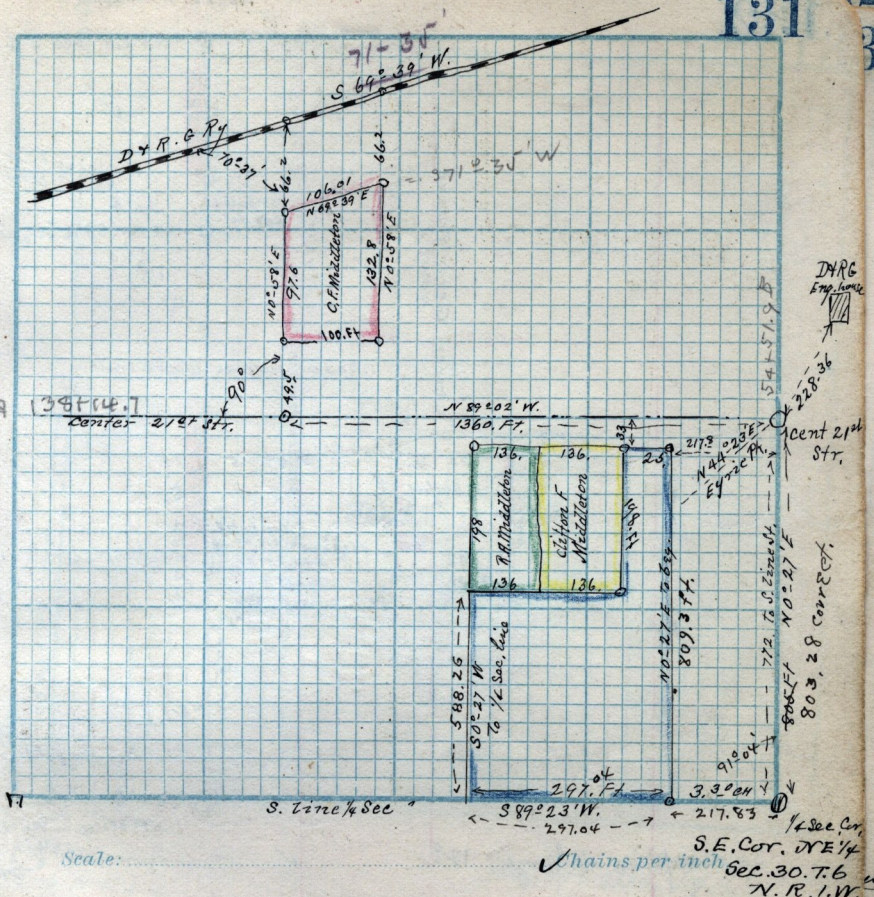

Scale: ..... Chains per inch

Survey for C.F. Middleton
in N.E. 1/4 Sec 30 T-6-N-R-1-W,
June 6-1890 -
by Edinger & party.