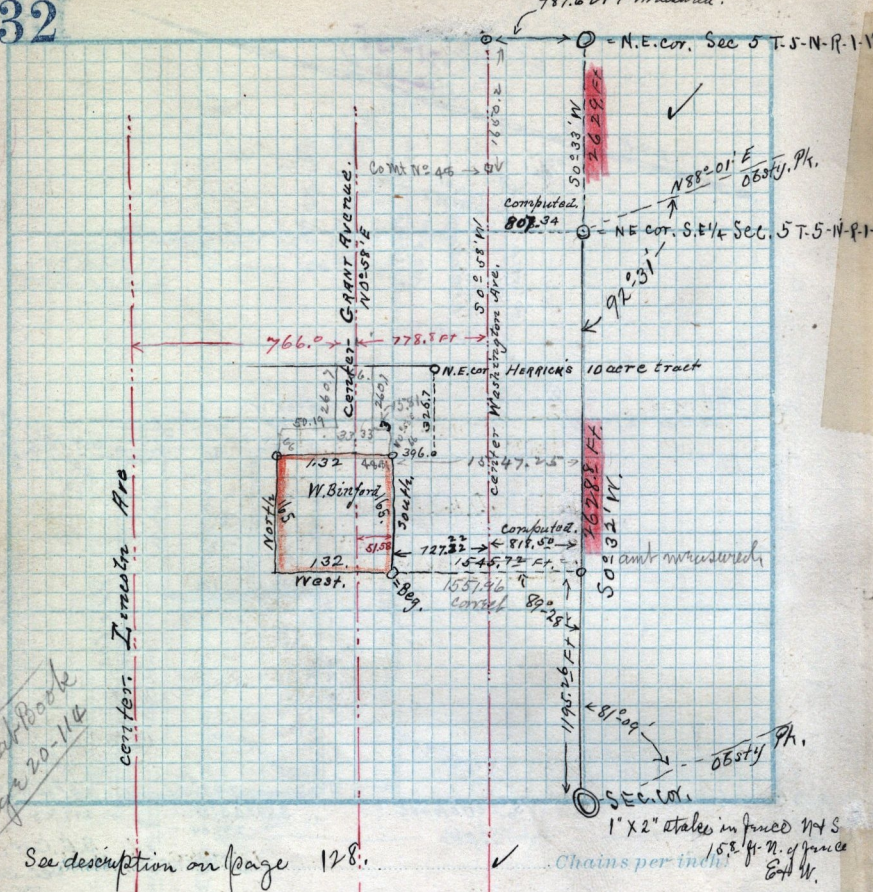

See Plat Book page 20-114

See description on page 128.

Survey for Wm. Binford in S.E 1/4 Sec. 5 T. 5-N-R-1-W.
by J. V. R. Schuyler + party.

June 6-1890.