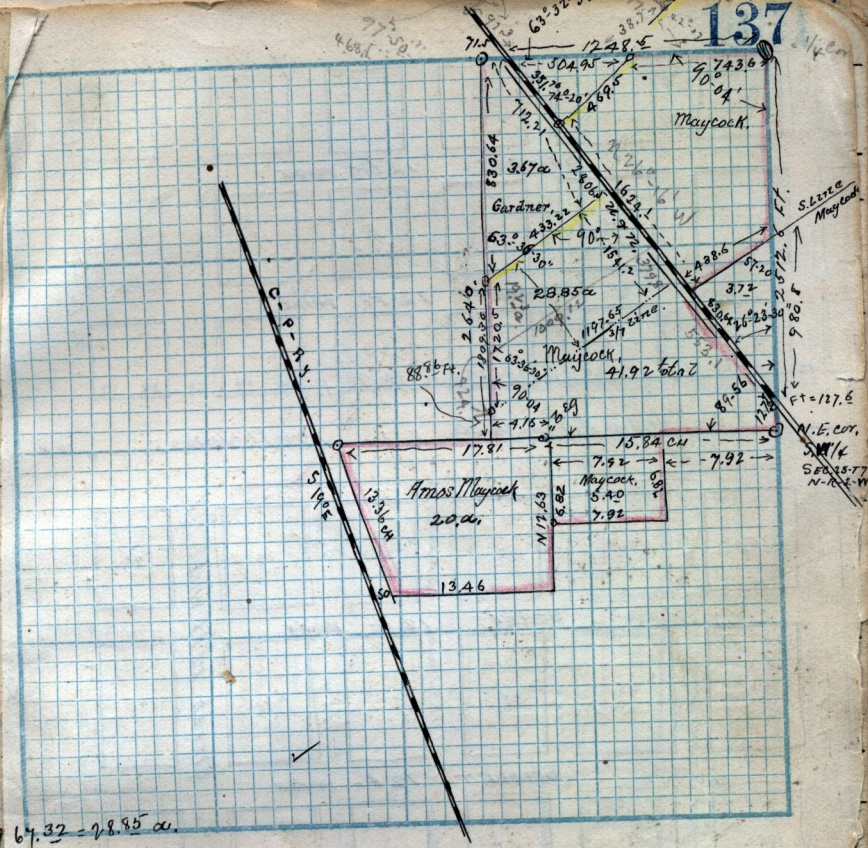

3/7 of 67.32 = 28.85 a.

3/7 of 3/8 of 67.32 a = 19.23 a.

Scale: ..... Chains per inch.

Copy of deed from John Mower to Amos Maycock – Feb. 4-1873 – H-270, Pt. S.W 1/4 Sec. 24 T-7-N-R.2-W, Beg. at S.E.cor. – W 10.60 ch. N. 30°30' W 42/100 of 1 ch, N 47°30' E 14.6 ch. S. to beg. 5.7/10 a. more or less. — Copy of deed from Francis E. Campbell & Wife to Amos Maycock. – July 13-1887, Y-400, Pt. S.W 1/4 Sec. 25. T-7-N-R.2.W Beg. 15.84 ch. W. of N.E. cor. said 1/4 Sec, W 17.81 ch. S 19° E, 13.36 ch. parallel to, 50. ft. E. of center of C.P. Ry. E 13.46 ch N 12.63 ch to beg. 20. a.

Copy of deed from Daniel Campbell & Wife to Amos Maycock, March 31st 1888, Z-305, Pt. S.W 1/4 Sec, 25 T-7-N-R-2-W. — Beg. 7.92 ch W. of N.E. cor. W. 7.92 ch, S 6.82 ch, E. 7.92 N 6.82 ch to beg. 5.40 a.