


STREET 18 FT WIDE

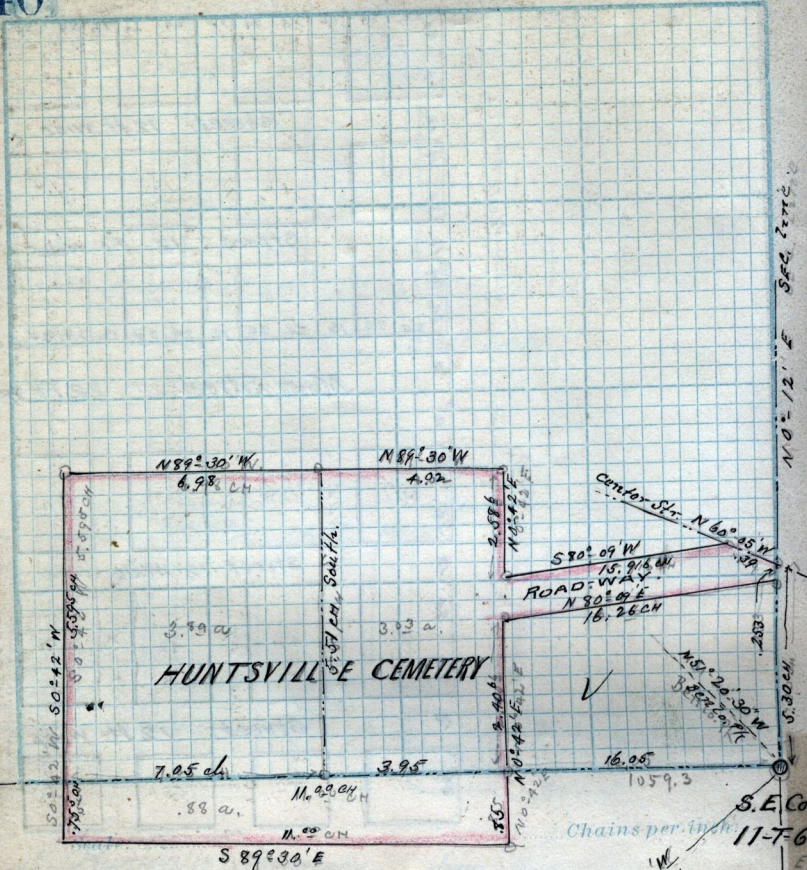

N 0° 12' E 564.20 CH

S. 30 CH

See page 139. for arrangement of Blocks.

June 17-18-19-1890-

A. Roster, August Lundquist Chairman

J. M. C. Vanter, Stables man, Self, Transit.

S 45° 01' W
Obst. PK

Su