


Survey of SEC 23 T-7-N-R-2-V

147

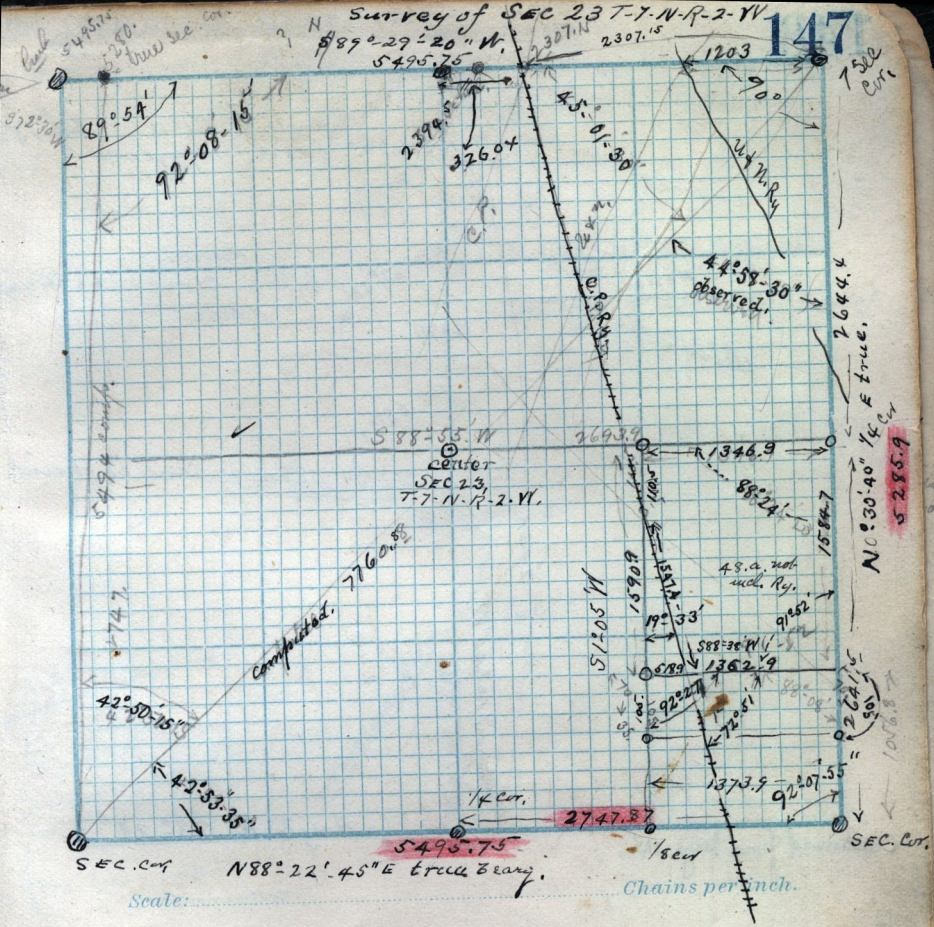

for R.A. Slater, & Ferriss July 25th - 26 - 27 1890 -