


August 8-1890-

152

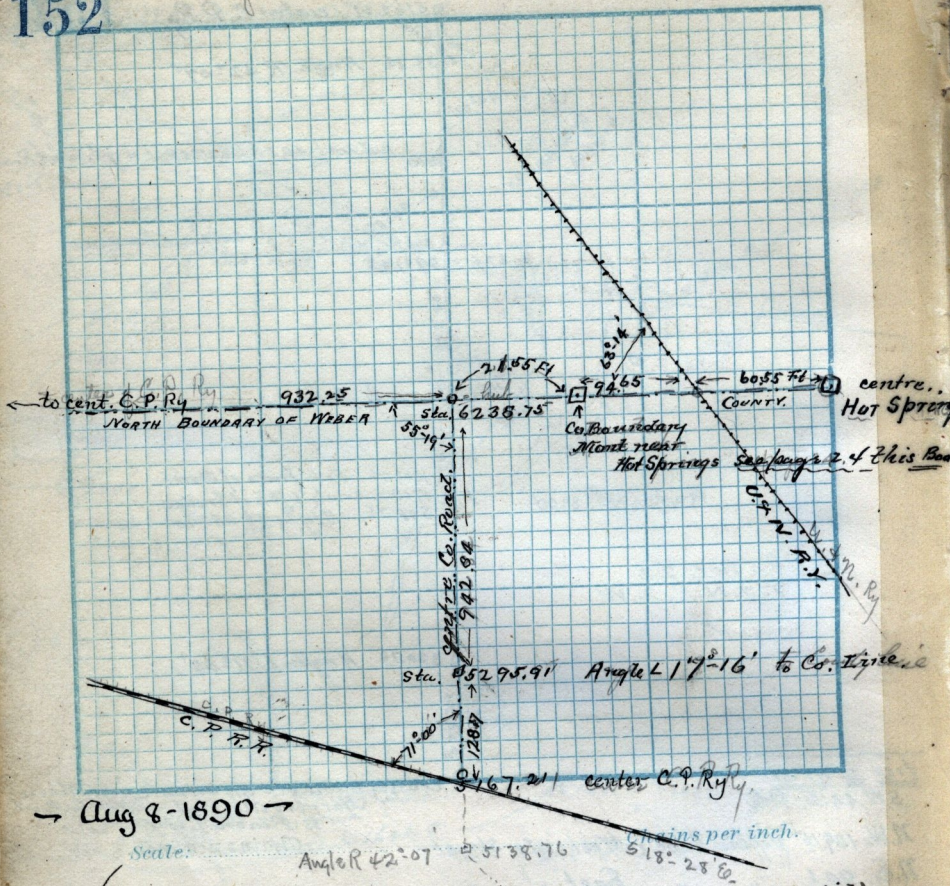

→ Aug 8-1890 →

✓ Re-survey of Co. Road from Harrisville
 to
Hot Springs