


John Miller

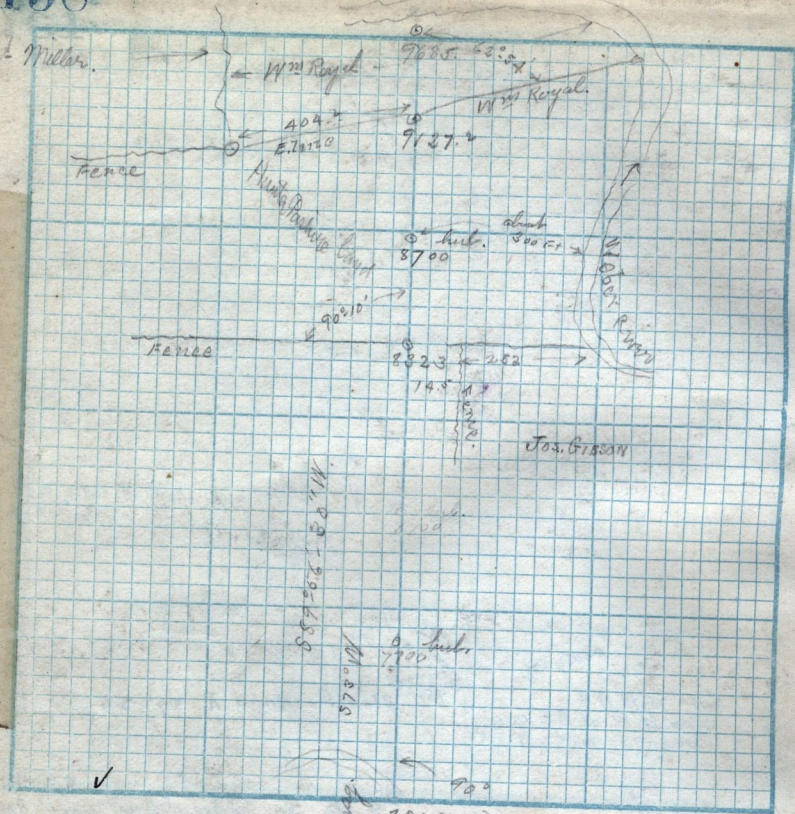

Scale:

1000
 7001.5
 Radine Property line
 Chains per inch.

Aug 20th 21st 1890