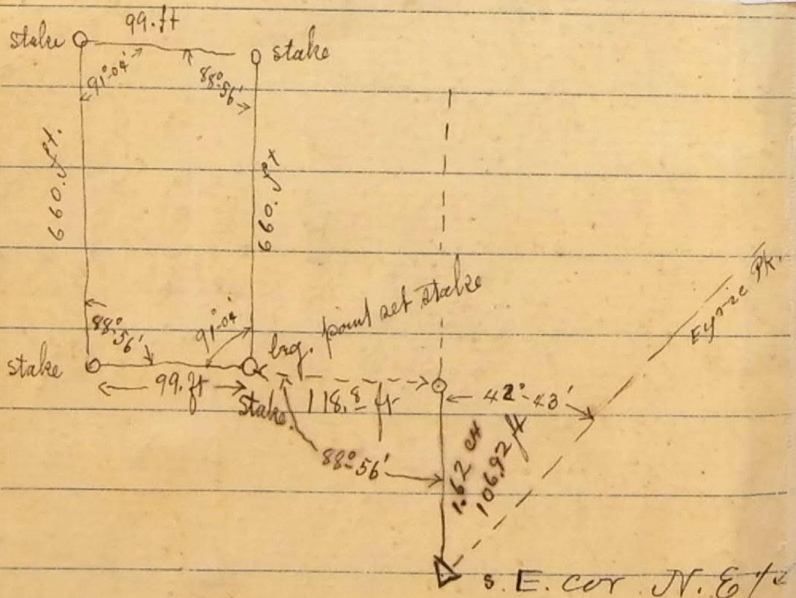
stake
99.7ft
stake
91°04'
88°56'
660.0 ft.
660.0 ft.
88°56'
91°04'
stake
99.7ft
Stake
118.8 ft
42°43'
Eyrie Pk.
88°56'
1.62 ch
106.92 ft
S.E. cor N.E 1/4
See 30
T-6.N.R.1-