1

N 33-13 E
S. gable N. Ogden Meeting house.

N 17-42 E

N 66-44 E
D.G. Pk.

S 20-17 E
U.S. observatory

S 62-21½ E
Wm Price Obs. Pk.

This Point is N.W. from Wm Price Place

No. 79

F 78

SANDSTONE
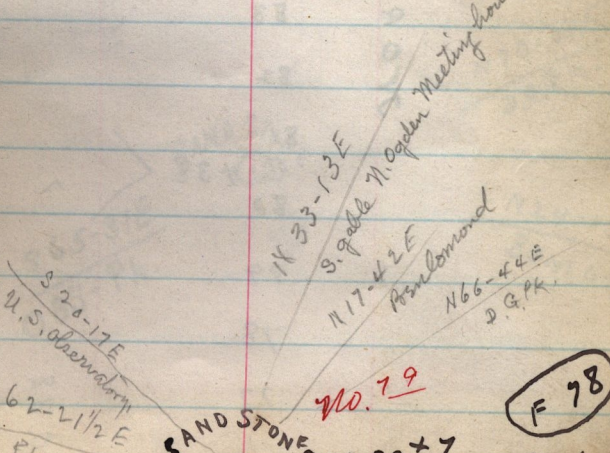
⊙ = STA 39 + 7 SEE Book
E Pg 79 = 78