


SEE Book F page (52)

Stone 83

The change of location  
 $835^{\circ}27'W.$ , 5.88 chains  
 was adopted and made  
 March 29-1886. by order  
 of Court.

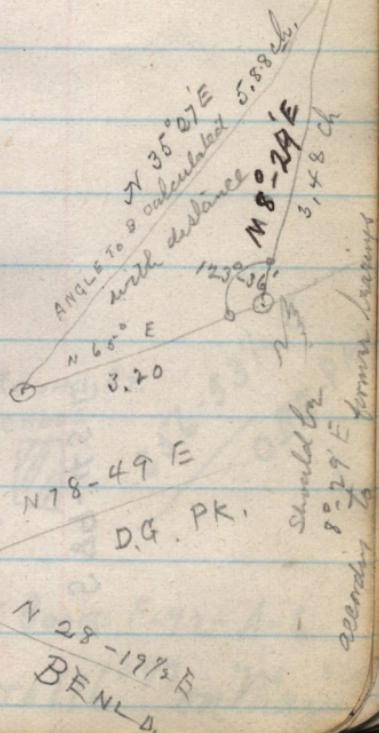

FROM HERE  
 TRIANGULATE  
 TO MAKE DIRECT  
 connection with  
 the school house