


61

7.68 should be 936 ft
from vertex
or Hub,

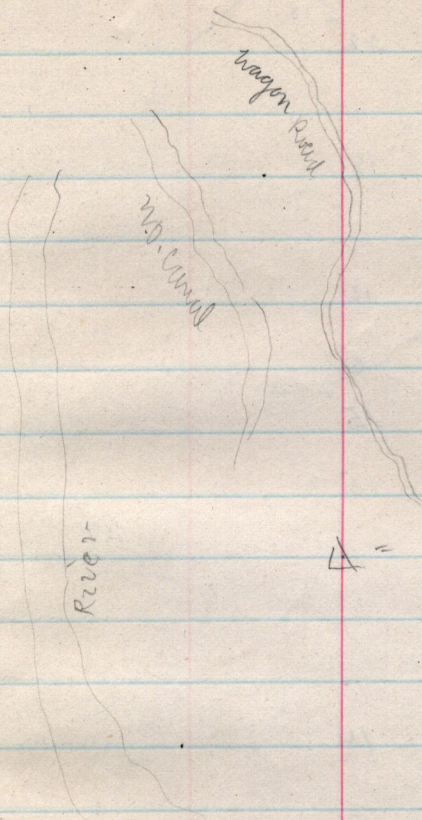

△ = mouth of cañon

1520 ft - 1520 ft