


Sept 5-1890 - Survey for Mrs. Knight, at Salt Creek.

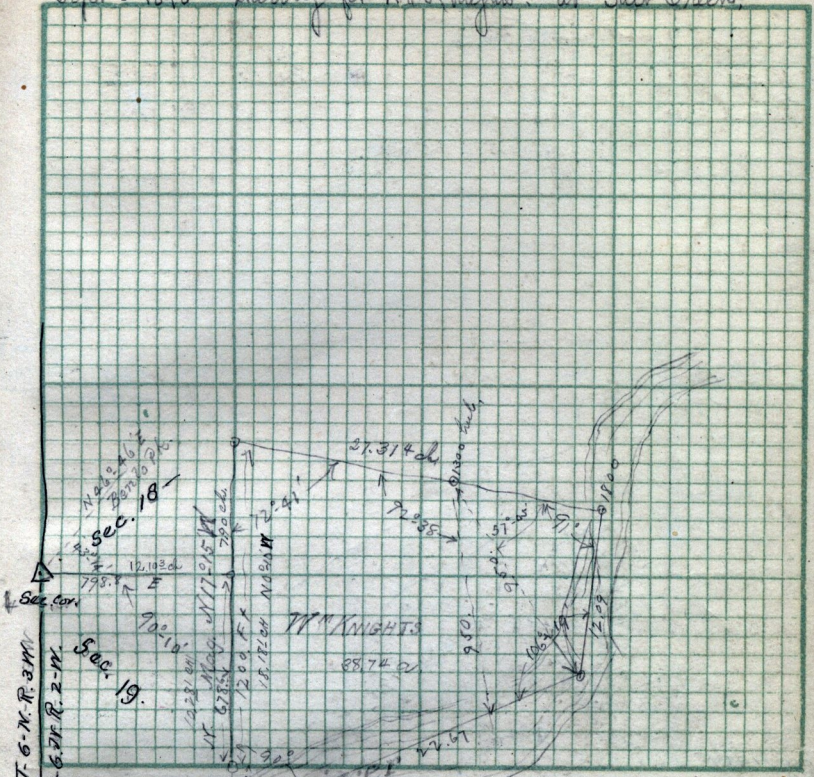

Scale: ..... Chains per inch.