


Sept 15 1890 - Survey made for Gordon

Anna Gordon

in N.E. 1/4 Sec. 7. T. 6. N. R. 1. W.

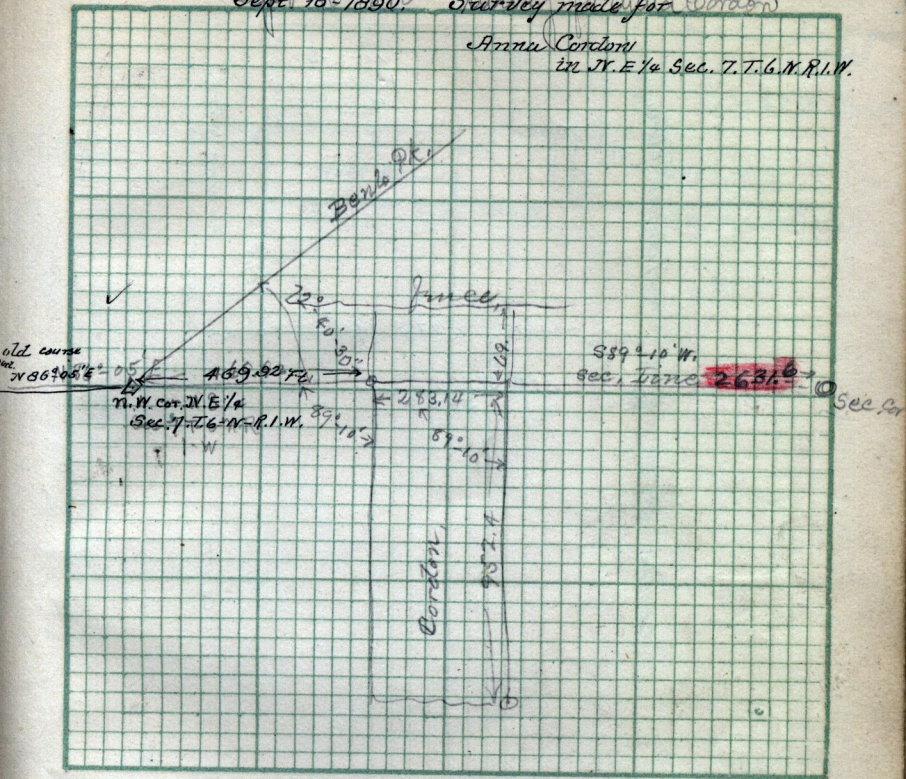

Scale: ..... Chains per inch.