
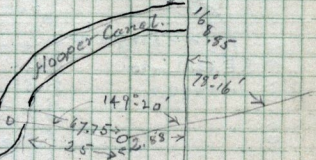


Survey of Part of Hooper Canal in Hobens' farm  
in Sec. 30. T. 6. N. R. 1. W.

Fence on West side of  
Hobens Farm.

⊙ = center of Sec. 30.  
T. 6. N. R. 1. W.

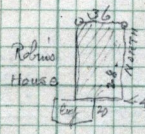

- 40. 21
- 40. 87.50
- 100. 65.18
- 150. 25
- 227. 0. 60
- 250. 77
- 320. 38
- 350. 90
- 400. 88
- 450. 89
- 500. 88
- 570. 80
- 680. 40

Scale: ..... Chains per inch.

770

