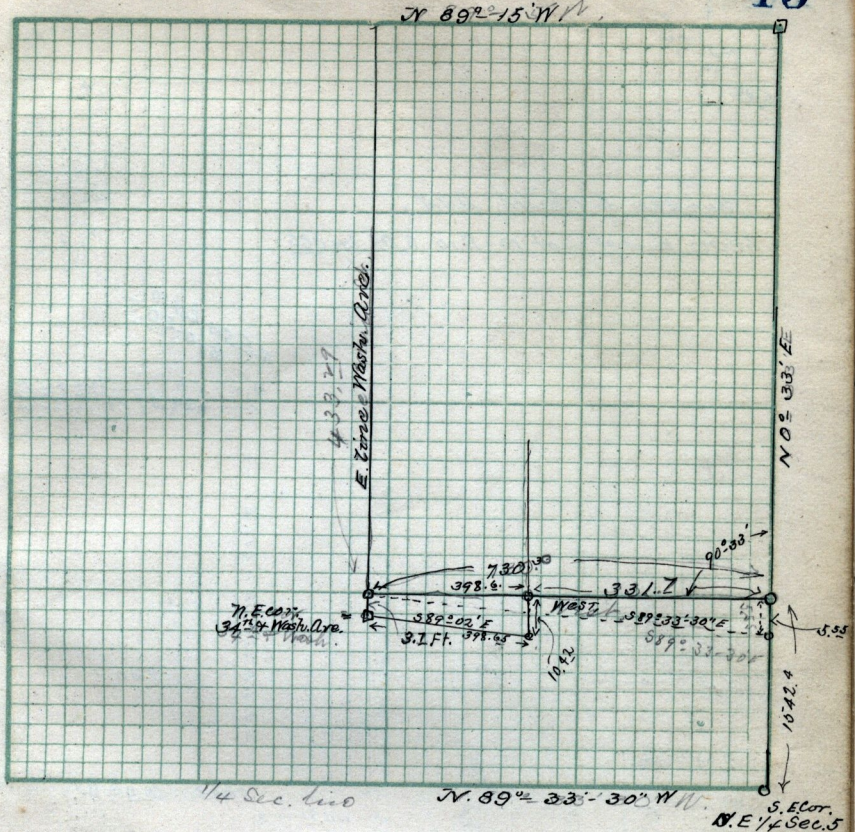

Scale: ..... Chains per inch.

Wm. Critchlow to Martha Ann Garner Critchlow