

Survey of Child Aced.
being part of Lot 10-B10. S.O.S. in OCS


N.E. Cor. Lot 10
B10. S.O.S.

439.69 Ft.

29 1/2 St.

center 29 1/2 St.

10 ft offset width of Center of Wood Ave
759.

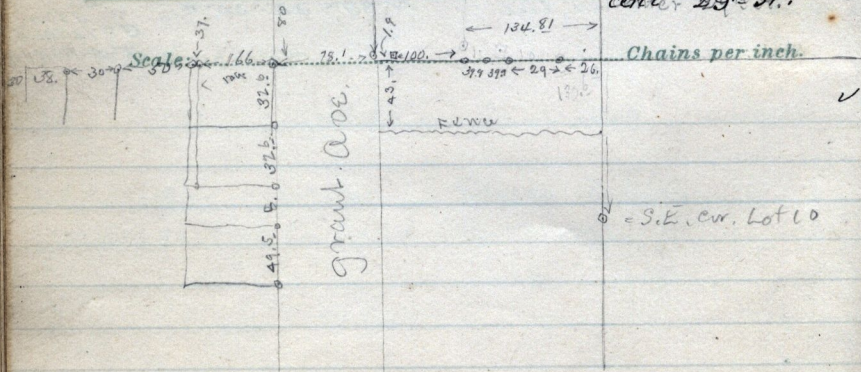

Scale

grant. A.C.E.

Chains per inch

S.E. Cor. Lot 10