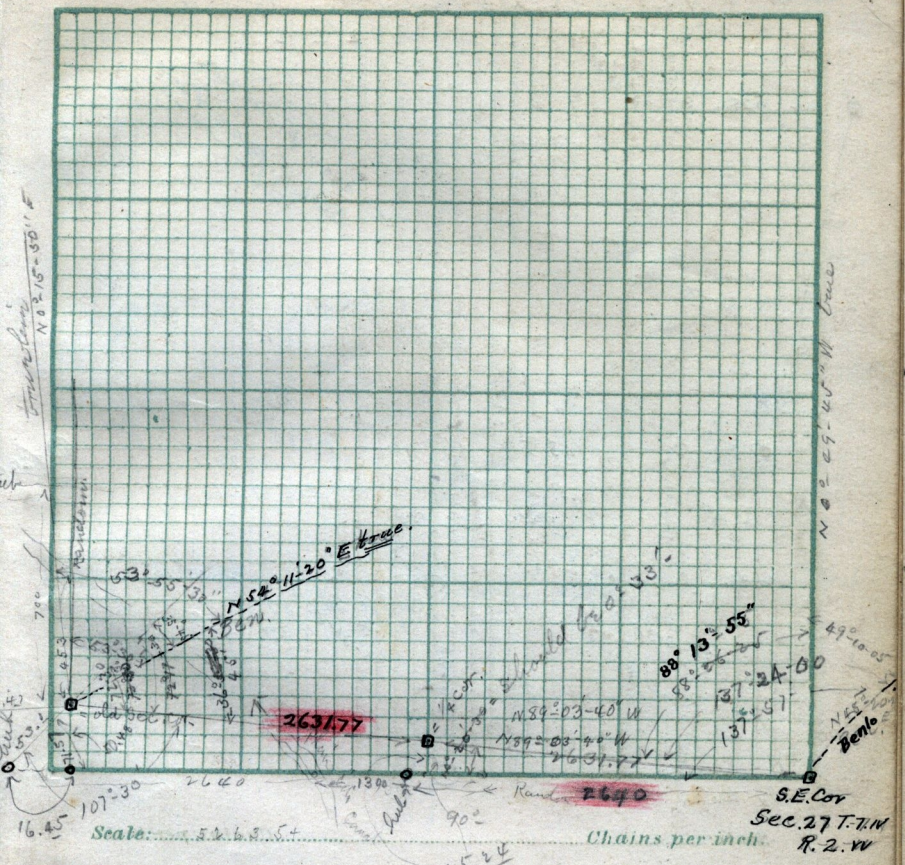

October 23-1890 - Oct 24th 1890 Survey for Robert W. Maw
others at Plain Ala Sec. 27. T. 7 N. R. 2 W.

See book C page 15
See page 35-44