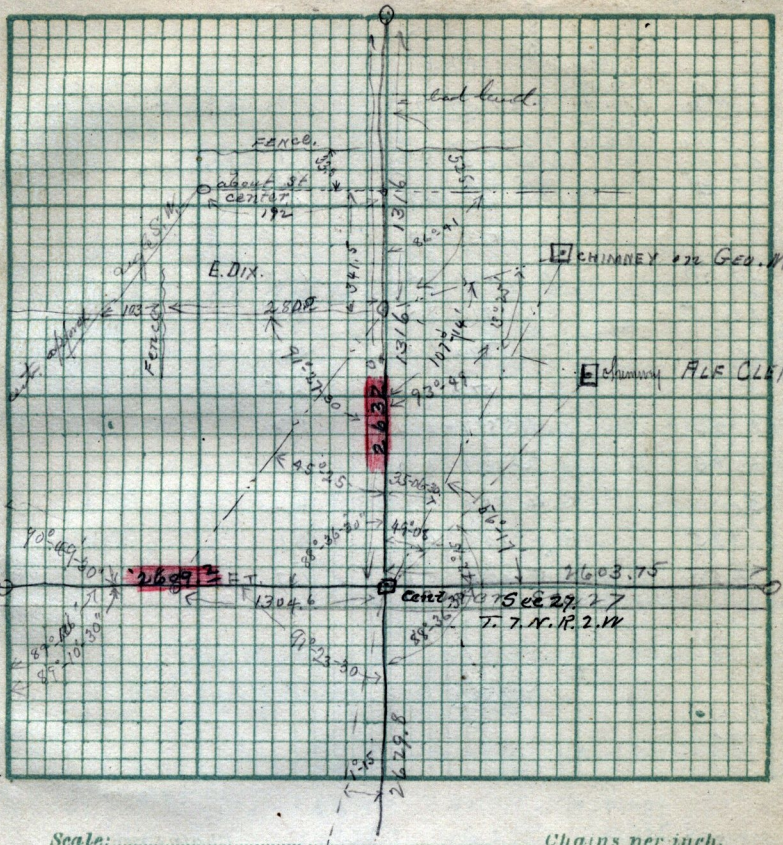

Scale: ..... Chains per inch.

Chimney on JENS POULS

55-30-30
35-53
91-23-30
88-36-30
180-00

2609.2
19.56
2628.76