See Field Book J-p.119- also Book L-Page 21

L-77- deed-from Jos. Hall to W.C. Parker - Pt. N.E. 1/4 Sec. 6 Tp. N-N-R.1.W

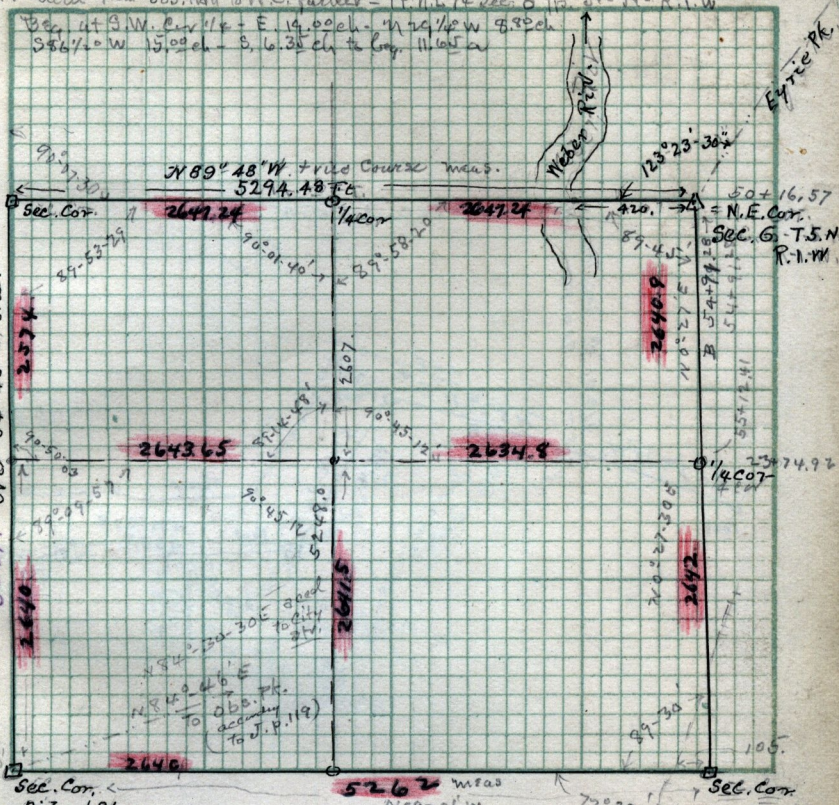

State Pile of Stones.

Scale:
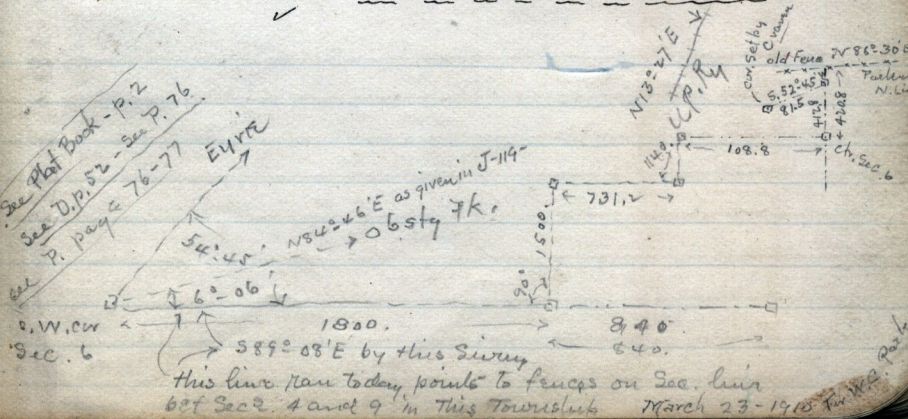
Sec. 6. T. 5. N. R. 1. West.