


Nov. 12-1890

B

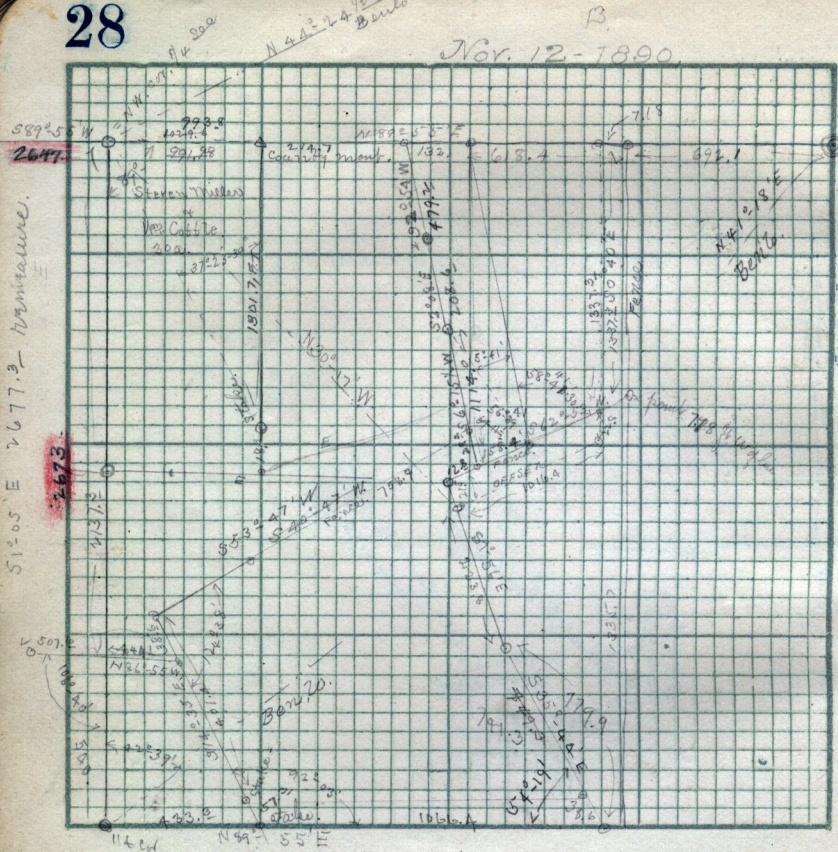

SE. 37.
collon
N. E.
to pin
S. V.
43.4
6 coll
tree

51°-05' E 2677.3. Normalure.

2673.

Scale: Chains per inch.

Survey of NE 1/4 Sec 3 T-6. N. R. 2. W.
for John A. Taylor & Henry Taylor 2. days.

See Plat Book
page 59