129-38 - 50-49 - 18 @ 27

129-38 58-48

Plan of deed from Charles Heath to Mrs H. Cottle

Oct 5th 1882 Pt N.E. 1/4 Sec 4 T-6-N-R-2-W. - Beg. at a point 12.1 Rods N of N.E. cor. S 52 Rods W 10 Rods N 52 R. E 10 Rods Beg.

Copy of deed from James Rowe to Peter McClaw Oct 16-1885 S-447.

Pt S.W. 1/4 Sec 34 T-7-N-R-2-W. Beg. 7.7 Rods E of S.W. cor. Sd 1/4 N 28 Rods E 10 Rods S 136 Rods W 10 Rods N 108 Rods to Beg.

Variation

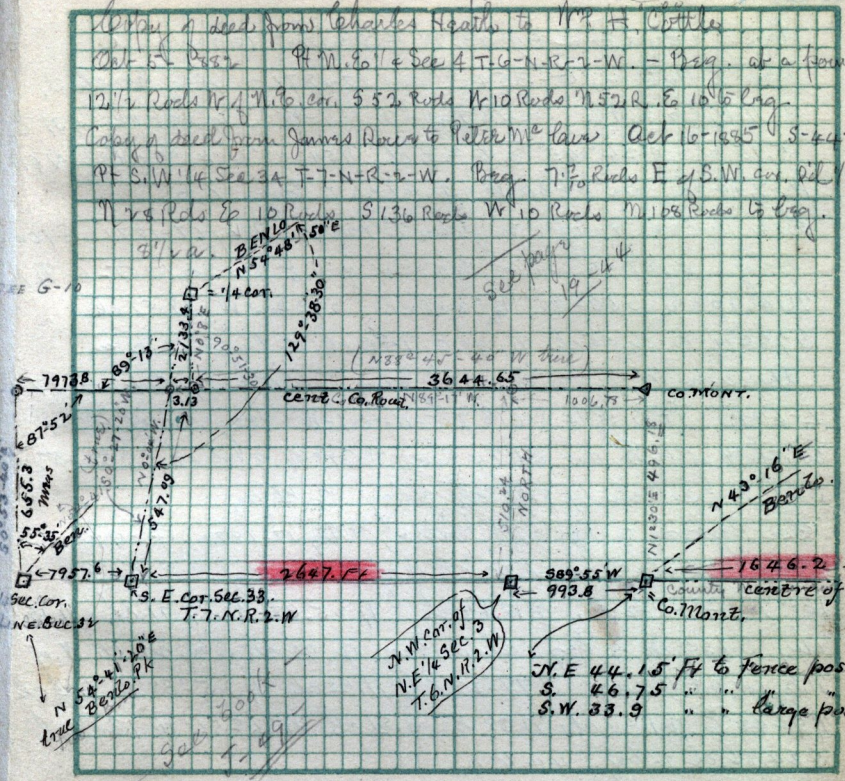

Scale: Nov. 28-29-1890 Chains per inch.

W 78.7 Ft to E. line of lot ( ) in Plain City Survey.
1326.3 Ft N along centre of St & S. parallel to E. line Sec 33
thence S 565.0 Ft to N 1/16 Cor.

C. P. Ry. Co. to Andrew Clark

S.W. 1/4 of N.E. 1/4 & N.W. 1/4 of S.E. 1/4, S.W. 1/4 of S.E. 1/4 & S.E. 1/4 of S.E. 1/4 Sec. 19. T. 7. N. R. 1. E.

(see Plat Book page 54)