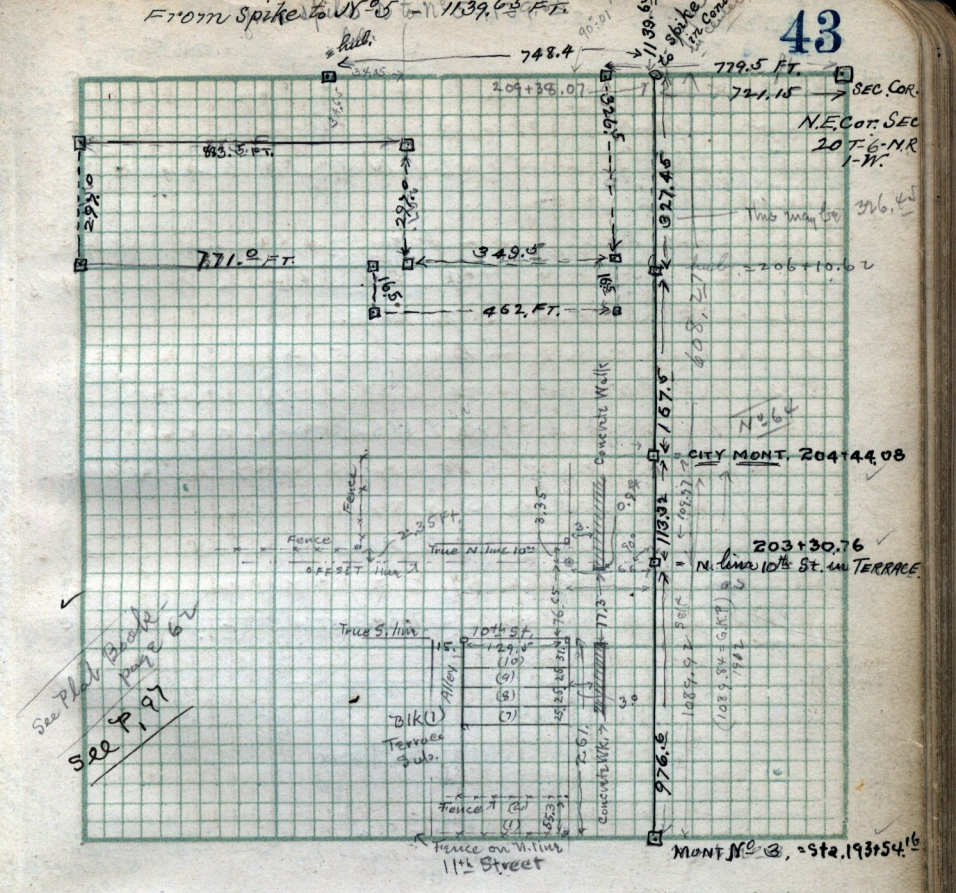

Scale: ..... Chains per inch.

lots 6-7-8-in B-56-Plat "A"-O-C-S.
Surveyed Jany-8-1891- Stake at corner
W. cor lots 6 & NE lot 8- S. W. lot 6- S. E. lot 8-

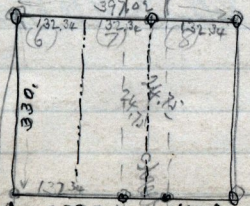

Fred V. Dankowske
bill $5.00

To here

760.5
99.
661.5
32.3
396.9

569.6
407
976.6

99.2
330.1
99.0
132.34
99.0