


54

Jane Hutchinson

Lots 5 + 6 -

Blk. 4 - Riverside

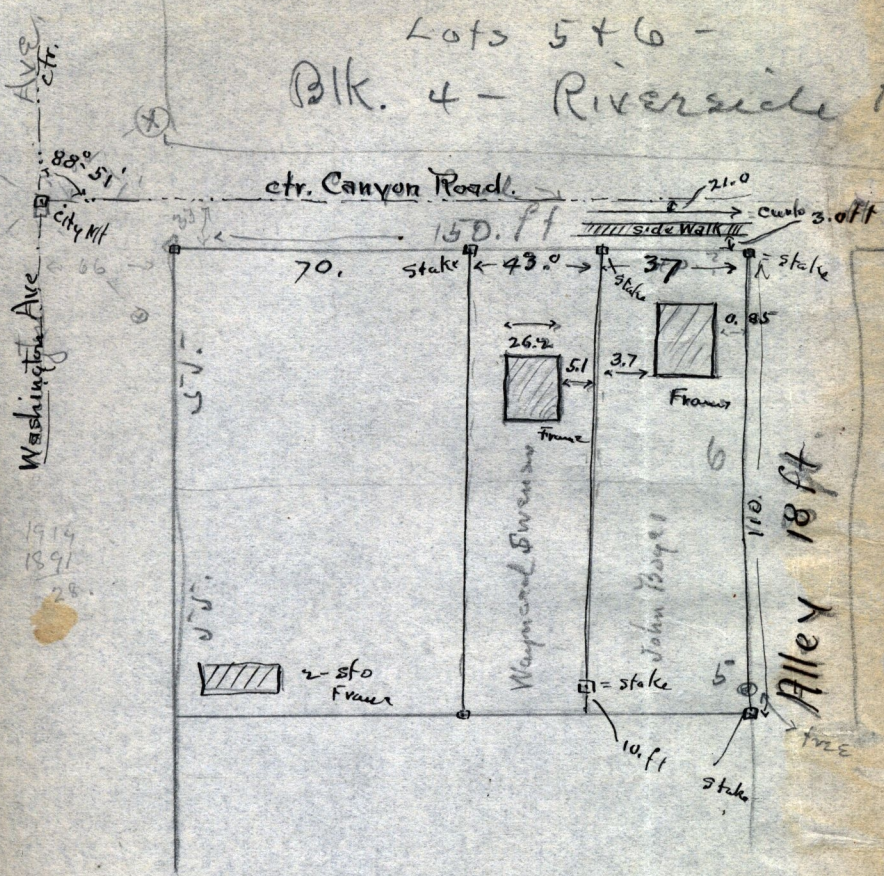

Agent = Mr. Loney

(Surveyed)
Aug. 2-1919

Phone 431 M -

Doc Murphy
Asstr.

29 + 6 + Washita