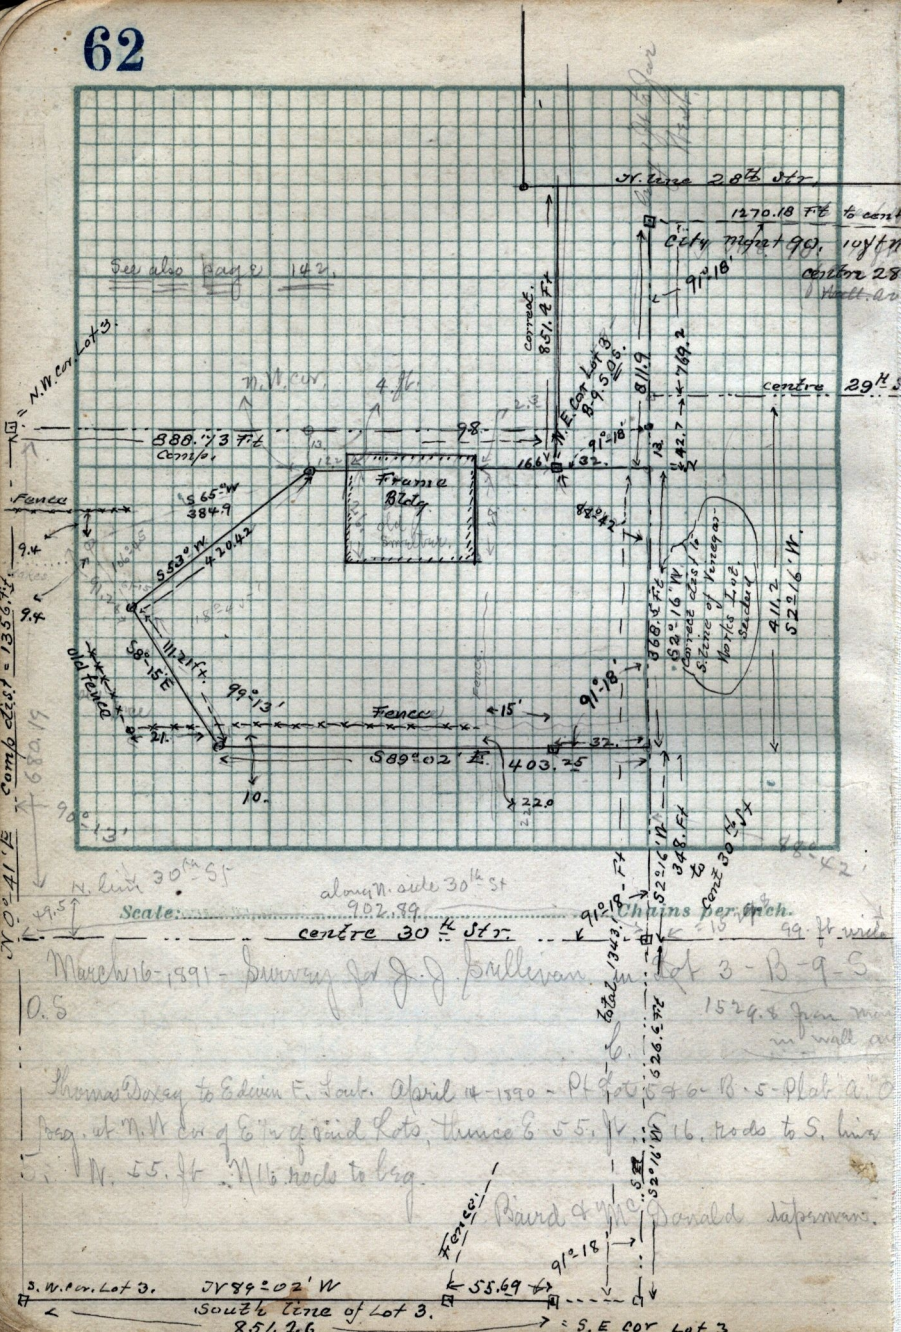
N. line 28th Str.
1270.18 Ft to cent
Cent. Mid. 90. 10 ft N
See also page 142.
corner 28
Mott. Av
N.W. cor. Lot 3.
N.W. cor.
4 Ft.
centre 29th St
888.73 Ft
Cent. Ln.
98.
N.E. cor Lot 3
S.89°03'E. 811.9
749.2
91°-18'
166
32.
12.
542.7
Frame Bldg
Fence
S 65° W
384.9
S 53° W
420.42
9.4
S 8°-15' E
111.21 Ft.
Old fence
99°-13'
Fence
15'
21.
S 89°-02' E. 403.25
10.
220
88°-42'
S 2°-16' W
388.3 Ft
411.2
S 2°-16' W.
91°-18'
N. Line 30th St
along N. side 30th St
902.99
Scale: Chains per Inch.
centre 30th Str.
99 ft wide
March 16-1891 - Survey for J. J. Sullivan
Lot 3 - B - 9 - S
O. S
Thomas Doxey to Edwin F. Lamb. April 4-1890 - Pt of Lots 5 & 6 - B. 5 - Plat A. O
beg. at N.W. cor of E ½ of said Lots, thence E 55. ft 16. rods to S. line
S. N. 55. ft. N 16 rods to beg.
S.W. cor. Lot 3.
N 89°-02' W
55.69
91°-18'
South line of Lot 3.
851.26
= S.E. cor Lot 3