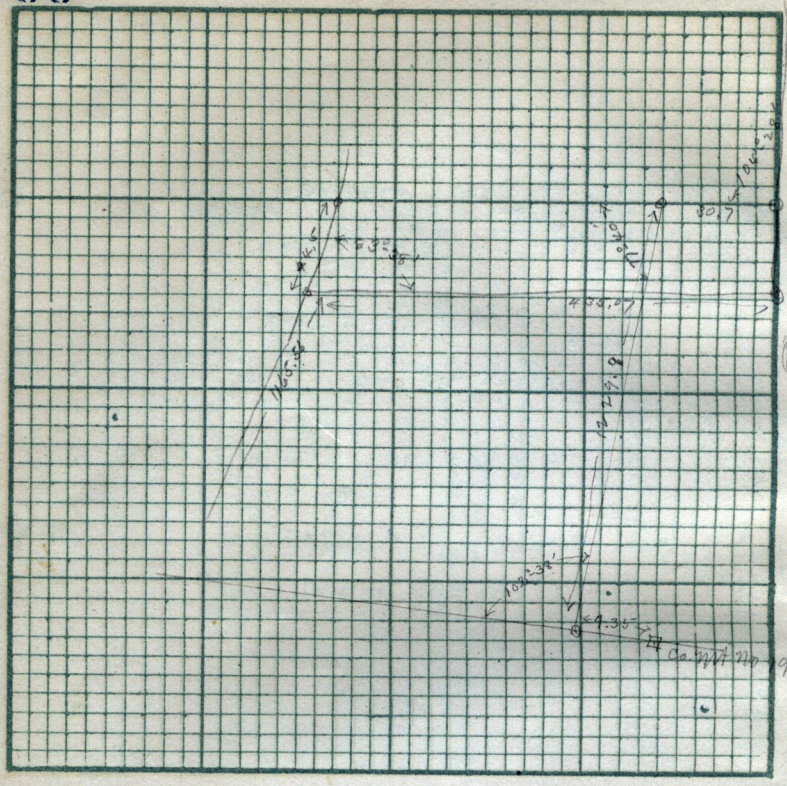

Scale: ..... Chains per inch.

See map on page 71.

Copy of deed from C.W. Thornton to Thomas Bennett Helm, dated, Oct 17-1876, - O-595, - Pt N.W 1/4 Sec 30-T-7-N-R-1-W. - Beg. 12.40 ch E. and 12.75 ch S 1° W. from N.W. cor of said Quar. S 59°-30' E 8.00 ch, S 82° E 3.00 ch, in Water ditch, S 1°-30' W. 25.96 ch, W 5.55 ch to centre of St, N 1° E 5.77 ch, in centre of street, N 57°-15' W 4.75 ch, N 27°-30' W. 6.70 ch, N 17° E 7.75 ch, N 18°-30' E 12.50 ch S 60° E 3.19 ch N 1° E 1.00 ch, to beg. 28.6/10 ac.

Also. deed from Jas. B. Alvord, to Thomas B. Helm, June 19-1877, O-9[illegible] Beg. 12.20 ch E, from N.W. cor. S.W 1/4 Sec 30, Town Ip. 7 N. R. 1 W. S. ch, S 1°-15' W 11.50 ch, N 89° W 5 ch, N 1° E, 11.45 ch on E. side of street to beg. 5.70/100 a. Surveyed March 25-1

See page 71-