


70

S. Line 28th Street

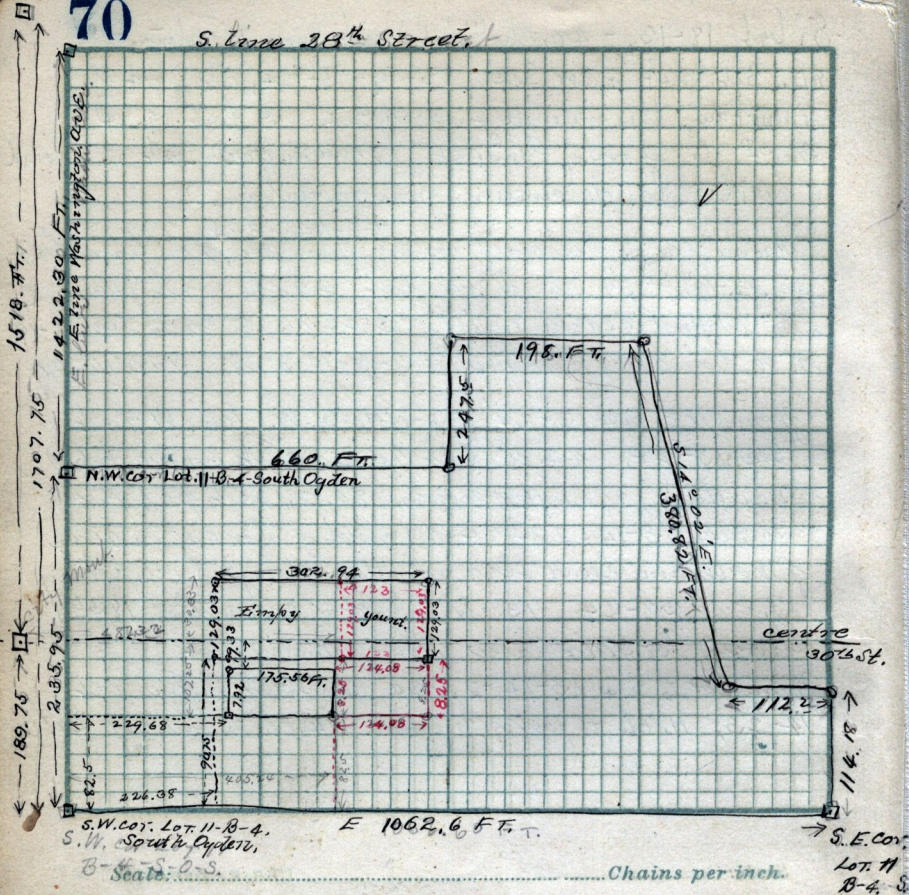

Survey for Alfred Campy, in South Ogden Survey
 March 24th 1891.

John Layman, }
 J. Baird } Chain

(- to here -)