74

Deflect. 0°06' South. for true Quar. Line Targ. = 0.0017 ℄

N55°30'E to Cyrus Pk.

West 40. ch = 66 = 2640. ft.

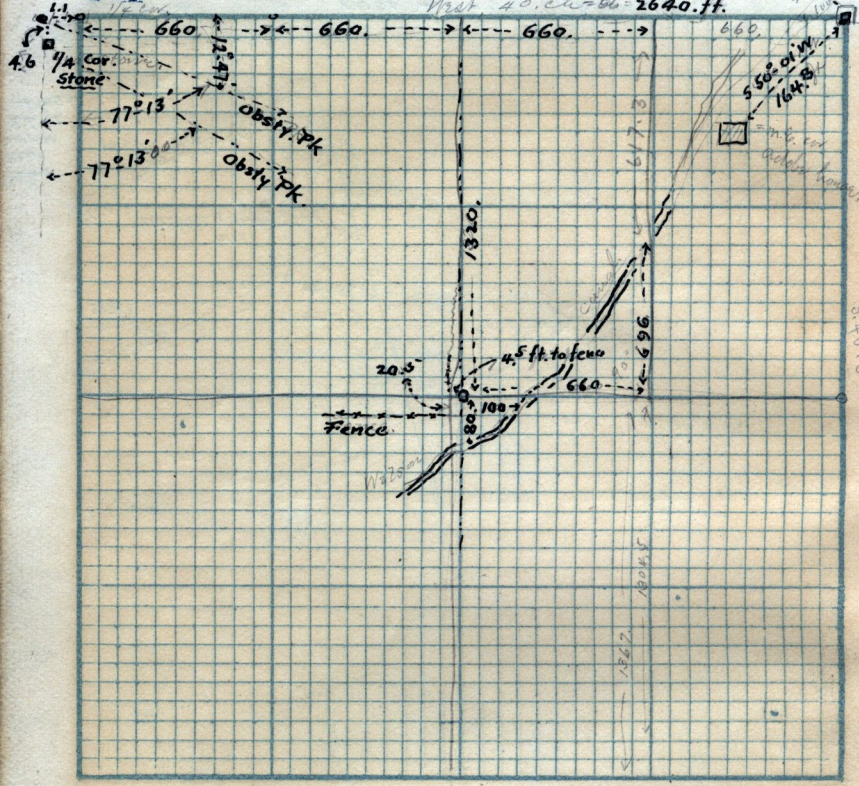

133. 9r. clear S. side of 3rd to Ctr, Canal

Scale: ..... Chains per inch.

See page 60. for description. Survey made April 1st 1891 - for Andrew Alexander, buy W½ of N.E¼ of S.E¼ Sec. 26 - T. 6 - N. R - 2 - W. Baird & Guyman tapa m'sm

S 14.98 ch to brg. 6¼ a, K-38 T. Read to Jos. Sewell, - Beg. 2.48 ch. E of S.W. cor. N 7.045 ch S 84°28' E 10.62 ch S 6.185 ch W 9.58 ch to brg. 6. a 1 r 13 p. - J-353 - T. Read to Levi Murdock - Beg 6.33 ch W. of S.E. cor. N 35° W 5.18 ch in mid of road. N 84½° W 9.82 ch in road S 5.345 ch on S. Stones E. line and 6¼ Sec. line, E 13. ch to brg. 3 a 3 r 33 p, L-116 - T. Read to Samuel Stones, - Beg 12.0 ch E of S.W. cor. N 6.185 ch ℄