See Page 16.

July 25-1919-survey for Wm Sewell

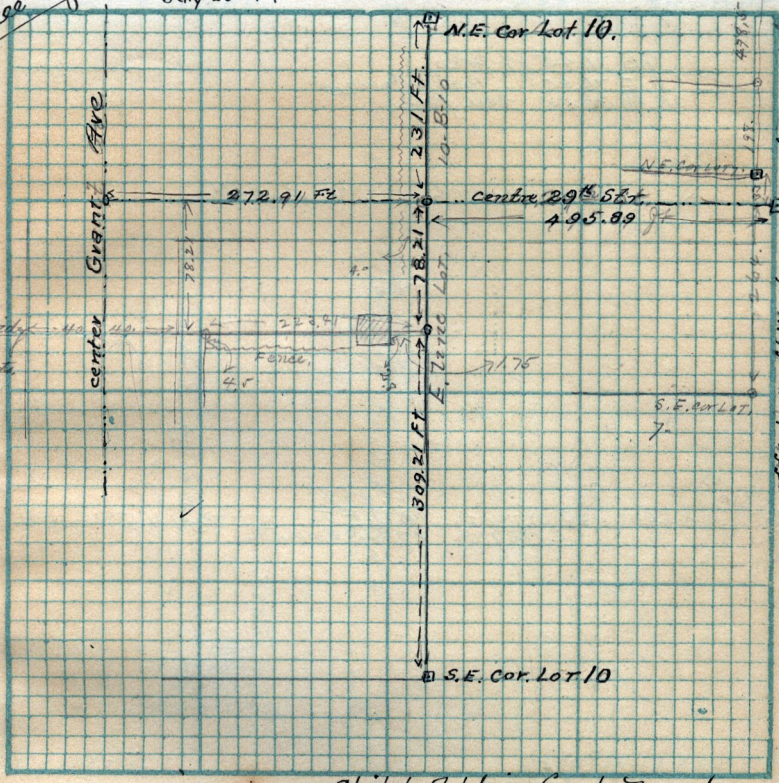

Child Add. in County Records
Plat Book 3-pg. 165

Scale: ..... Chains per inch.

April 1st 1891 - Survey made for Moroni Brown, in Lot. 10-B-10-South Ogden Survey.
Baird & Layman Tape men

thence 10.74 ch S 84° 28' E 5.345 ch W 9.69 ch to beg. 5 a,
E. 164. T-Read to Richards Ringrose - Beg. 15.10 ch S. and 14.63 ch
E of N.W. cor. thence S 66° 47' E 22.85 ch N 6° 50' E 19.50 ch N 55° 39' W
.85 ch. S 43° 56' W 5.38 ch S 22° 36' W 4.21 ch N 84° 15' W 17.57
1° 27' E 3.54 ch to beg. 24 a, L-166, T-Read to Jos. James,
Beg. 4.53 ch E of N.W. cor. & 15.10 ch S. therefrom. S 18.12 ch S 84° 28' E
10.61 ch. - N 1° 27' W 18.95 ch - N 10.12 ch to beg. 19.22 a (78)