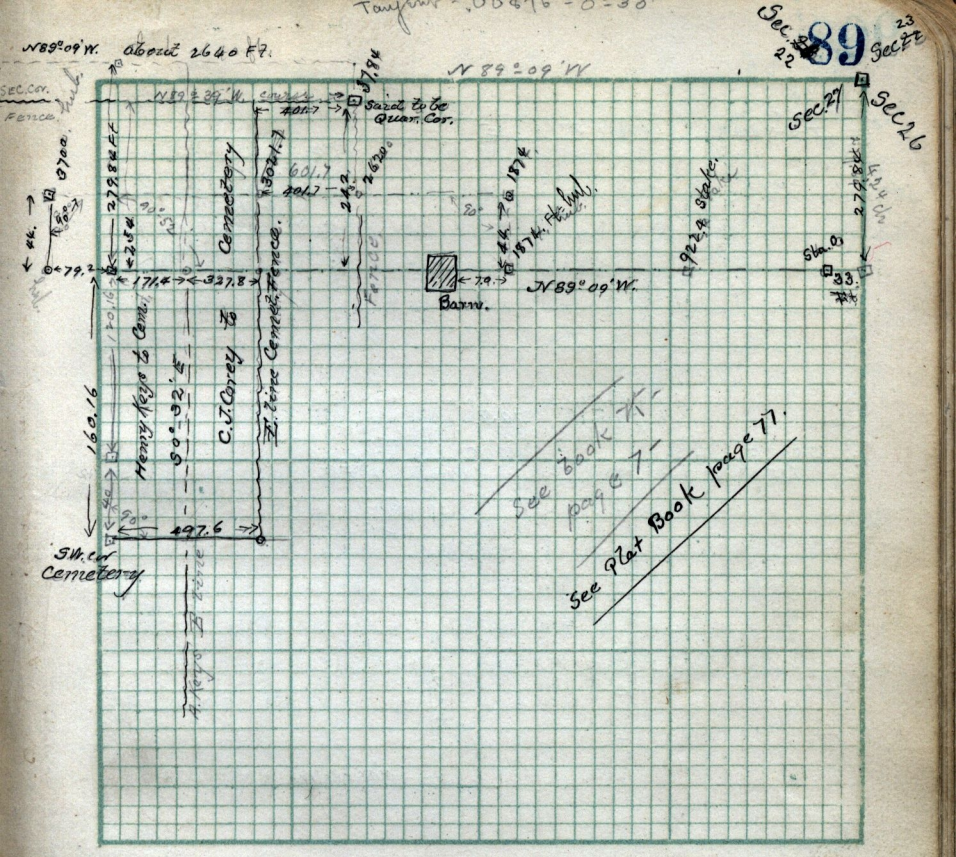
N89°09'W. about 2640 Ft.
Sec. 22
Sec. 23
Sec. 27
Sec. 26
N 89°-09' W.
Sec. Cor.
Fence
N89°39'W.
Corner
