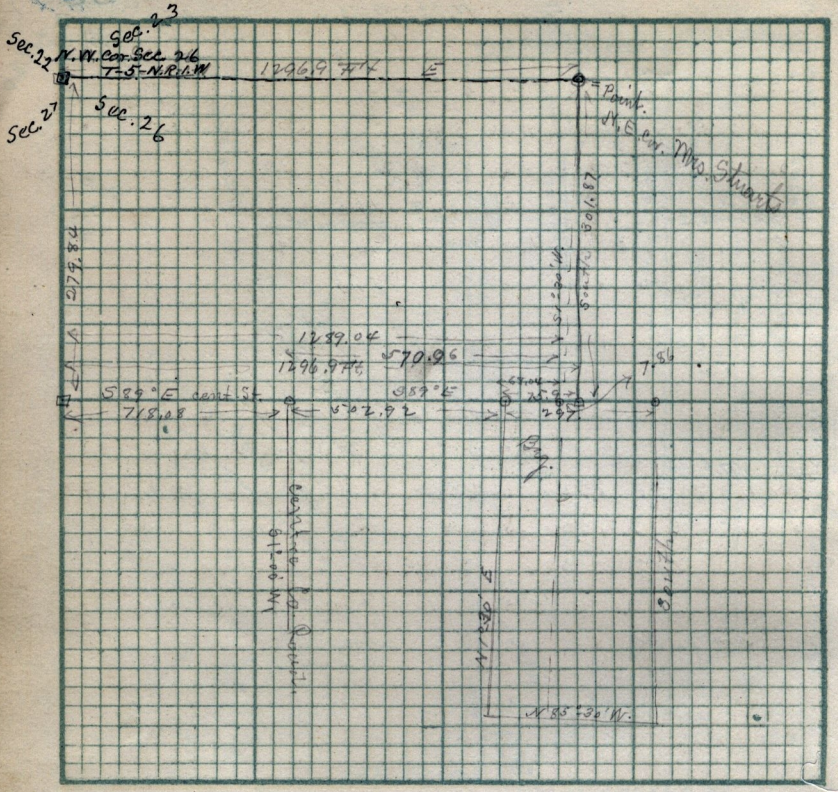

Scale: ..... Chains per inch.

May 4-1891 Survey of the following tract for the purpose of cutting out a tract for L.D. Meeting house for Uintah.

Copy of deed from Chas E. Spaulding to Susan D. A. Stuart Q-372, 9 7/ N.W. Quar Sec 26 T-5-N. R. 1 W Beg 18.58 ch E. of N.W. cor pd 1/4 Sec. E 4.50 ch S 12.94 ch N 85 1/2° W 4.71 N 1 1/2° W 12.92 ch to beg. 5.93 a.

Copy of deed from G. L. Conry to Alma Keys.

Beg 20 ch E. N.W. cr. Sec 26 T-5-N-R-1 W. E. 4.50 S 1 1/4° W 4.29 N 12.98 ch to beg.