2-334 – Winslow Farr to Lorn Farr - Beg. 34 rods 5 ft E. of N.W. cor S 20. rods E 8 rods N. & W. to Beg. Z-385

5-438 Aaron Farr to Stella Spangenberg. U-36.
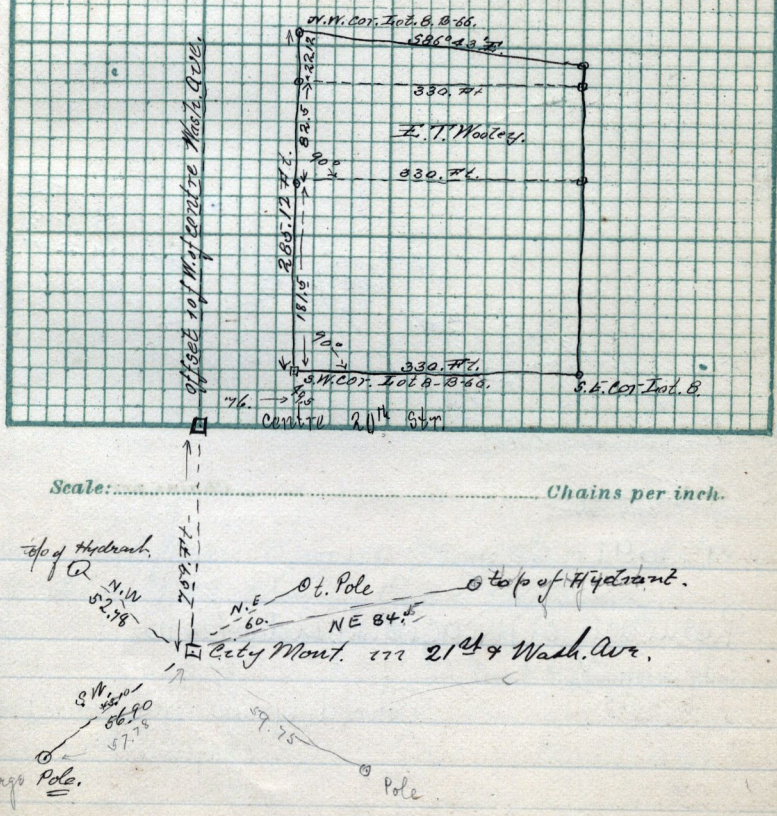
4-432. Wm F. Farr to E. T. Wooley and Robert Jones, Jany 28-1889. Pt Lot 8-B-66. Plat. C. - Beg 181.5 ft. N. of S.W. cor. said lot, N 5 rods E. 20. rods S 5. rods W 20. rods to beg.