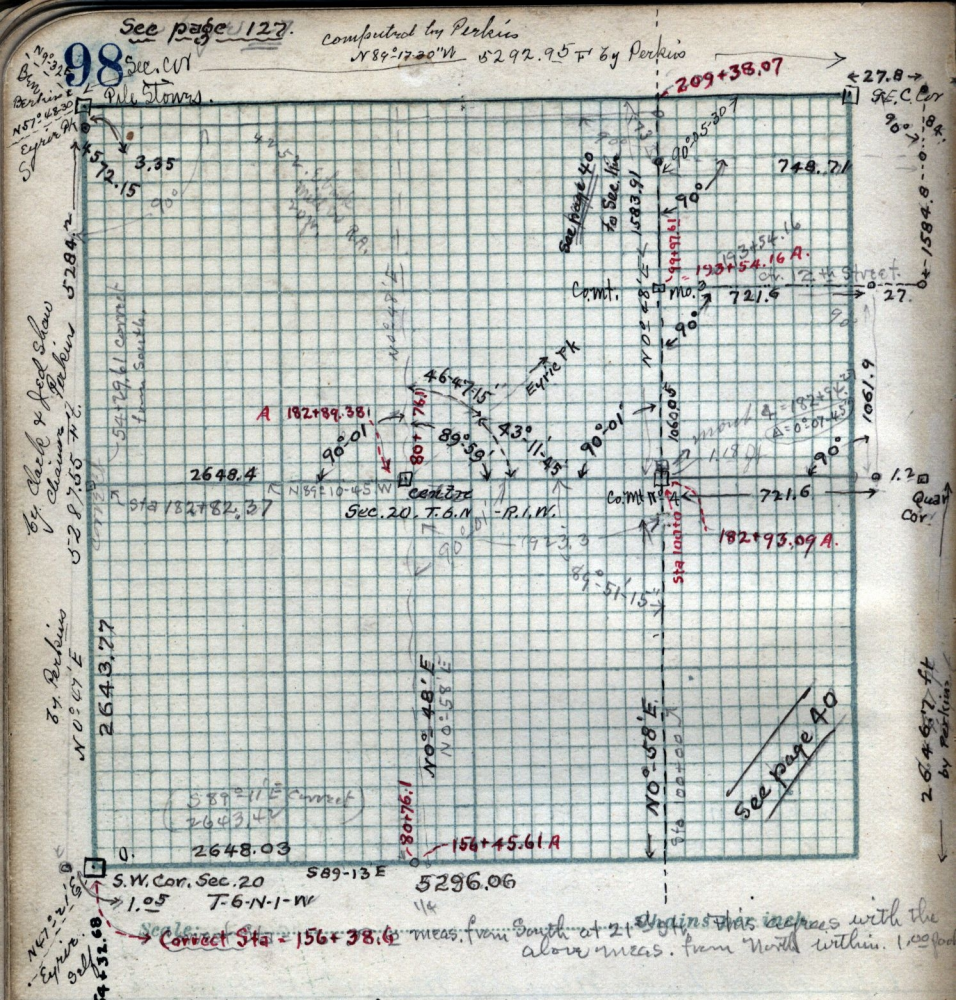

N. 372 - The heirs of the Charles McGarry estate to Magnus Cederstrom Beg. 19.96 ch. W. & 2.20 ch. N. of S.E. cor. of S.E 1/4 Sec 17. T-6. N.R.1.W. ~~Beg.~~ Thence N. 4. ch. W 10. ch. S 4. ch. E 10. ch to beg. 4. a. - No. 908. Wash. Ave. Ogden

Y. 417. Heirs of the estate of C. McGarry to Lars G. Levedahl. Beg. 21.75 ch W. of N.E. cor. of N.E 1/4 Sec 20, in same Tp. N. 2.20 ch, W. 9.25 ch, S 2.70 ch, E. 9.25 ch N 50/100 of 1 ch to beg.