RICHMOND CITY SURVEY

MAY-25-1891-

Cache Co. Utah.

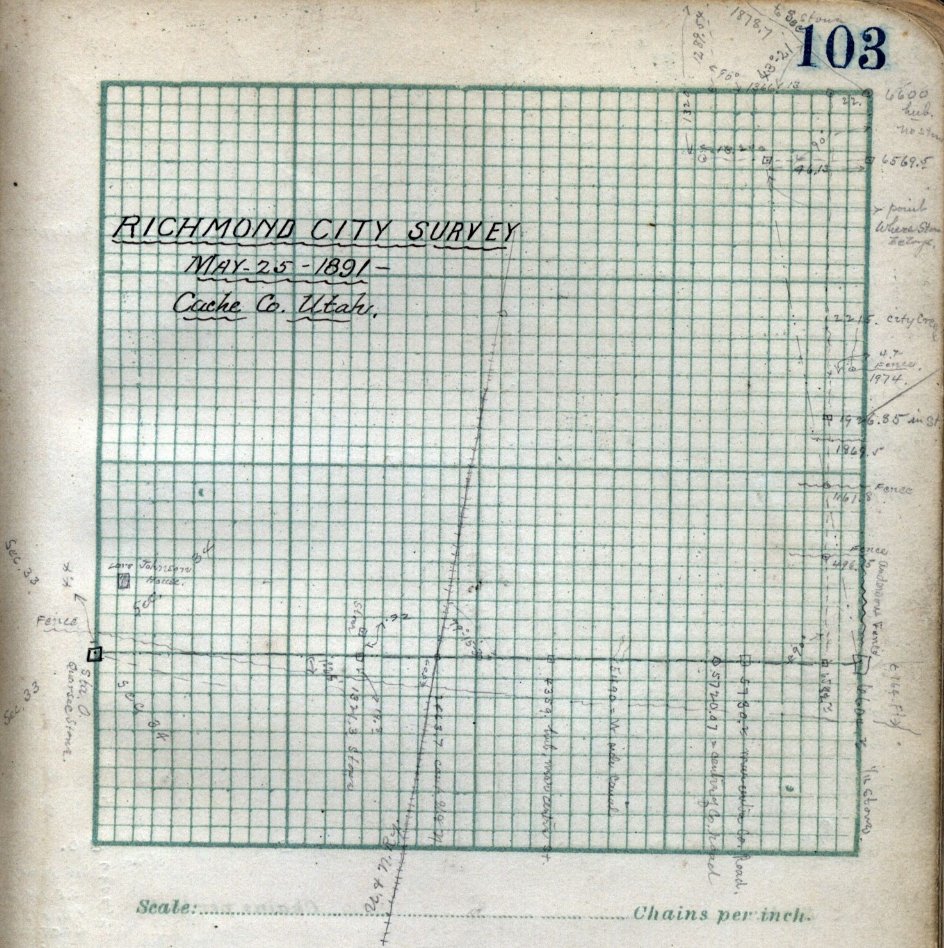

Scale: .... Chains per inch.

May 25- Survey of Richmond City Cache Co. Utah, by self. Layman and Baird Chainmen George Burnham hind flagman.

Runing N. at R.A. to S. line City Entry on random offset line 22. ft West of S.E. cor. of N½ of N.W.¼ Sec 35 T-14. N. R-1. E. 496.5 fence 1161.8 fence 1869.5 fence ^1926.85 hub 1974. fence 2215 city cor 10. ft hub 3449.52 ft ^R.A. 12. ft to right near centre 4211.60 ^hub near centre ^Main St. of St. 4760. north fence 4900. hub. ^5024.5 n. line St. 16.7 -6. of N. line of St. 5123. south Edge of Irrigation ditch 10 ft over S.W. ^5426. Fence 6087. Fence E. & W. 6296.10 hub. R.A 12. ft to left, ^6600. hub Ra. Right 22. ft to random Cor. 30.5 ft N. & 46.13 ft E of point 1320 ft S & 1320 ft E of stone said to be N. ^E. cor ~~W. cor of S.W.¼ N.W.¼ Sec 26~~ ^Sec 27 T-14-N. R. 1. E.

(Continued on page 104.)