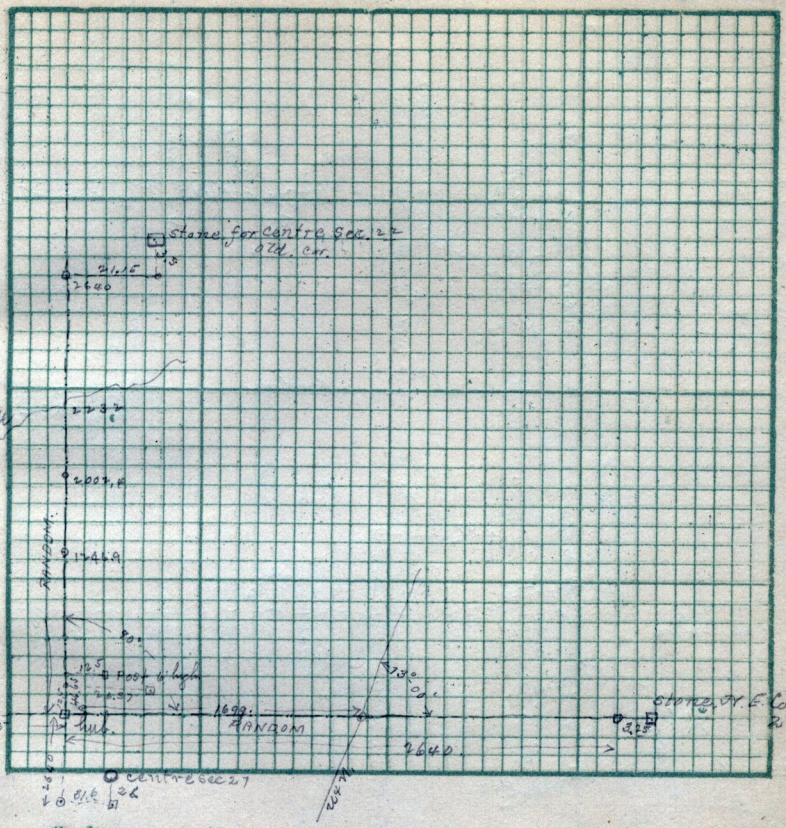

Scale: [illegible] Chains per inch.

2640 hub.
783. fence N.45.

R.A. to Mile 1758.52 from Sta 2640. = hub 23.12 / 21.85 ft S. of Stone set for N.W. cor of E¼ of S.W¼ Sec 27 (1276.72) = R.A. South begin New Stations on N. line City Territy. Mag. S 17° 10' E. 1414 fence E & W. near creek. 2485. fence S. side Street E & W. 2900 hub. 2007.5 = Crty Cr. very crooked Chaining generally N. N.W. 5253.51 intersect South line city Territy 2.32 ft N of point 1321.32 E. of Quar Sec. stone & 7.92 ft S of Stone

May 24th 1891 - Richmond, Surveyor. Brg. at hub 46.65 ft S. & 12.5 ft W. of post. Set by Co. Surveyor for Quar Cor. on N. line Sec 27. thence N. at R.A. to line from E (mag. N 17° 20' W.) 1246.9 hub in field South of deep ravine E & W. 2002.4 hub. on side hill sloping into Crib Cr. West 2232. small Cr. 10 ft S. bank. very S.W. into Crib. Cr.