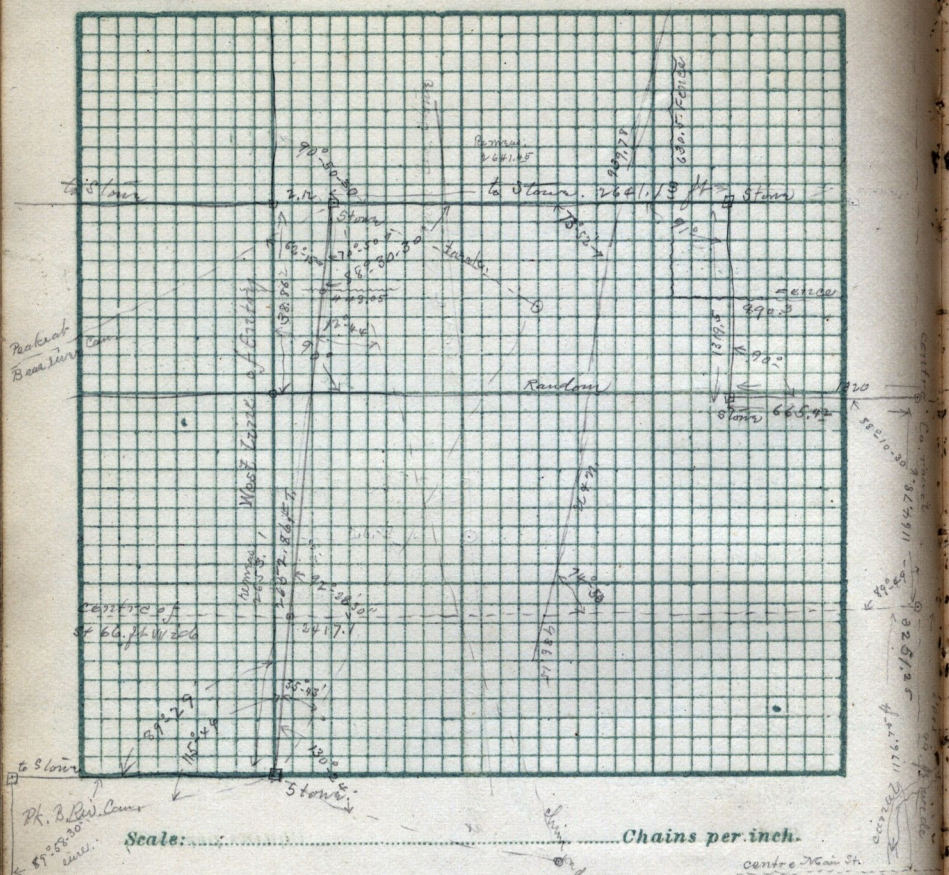

Richmond Survey. Beg. 2640 ft. W. of centre of Sec 27, Tp 6 R. 4. E. 1st Random line bet. North & our random line, thence W. 232. to Jones N. 45. 1287.9 = Meas. 20.25 ft South S. W. cor. N. W. 1/4 Sec 27.

May 28-1891 - Richmond City Survey. Beg. at true N. W. cor. N. E. 1/4 Sec 27. Running South (Mag. S 18° E. Thence S.E. & ly. with N. & W. lines of said Quar. = 88°-30'-30" the total length of said lines from N. to S. = 2652.86 ft.) 448.05 - Jones E. & W.