


Iron bolt = A 133 + 57.08  
B 0 + 87.02 } city sta.  
calculated from S. & E.  
See correction in 'K'

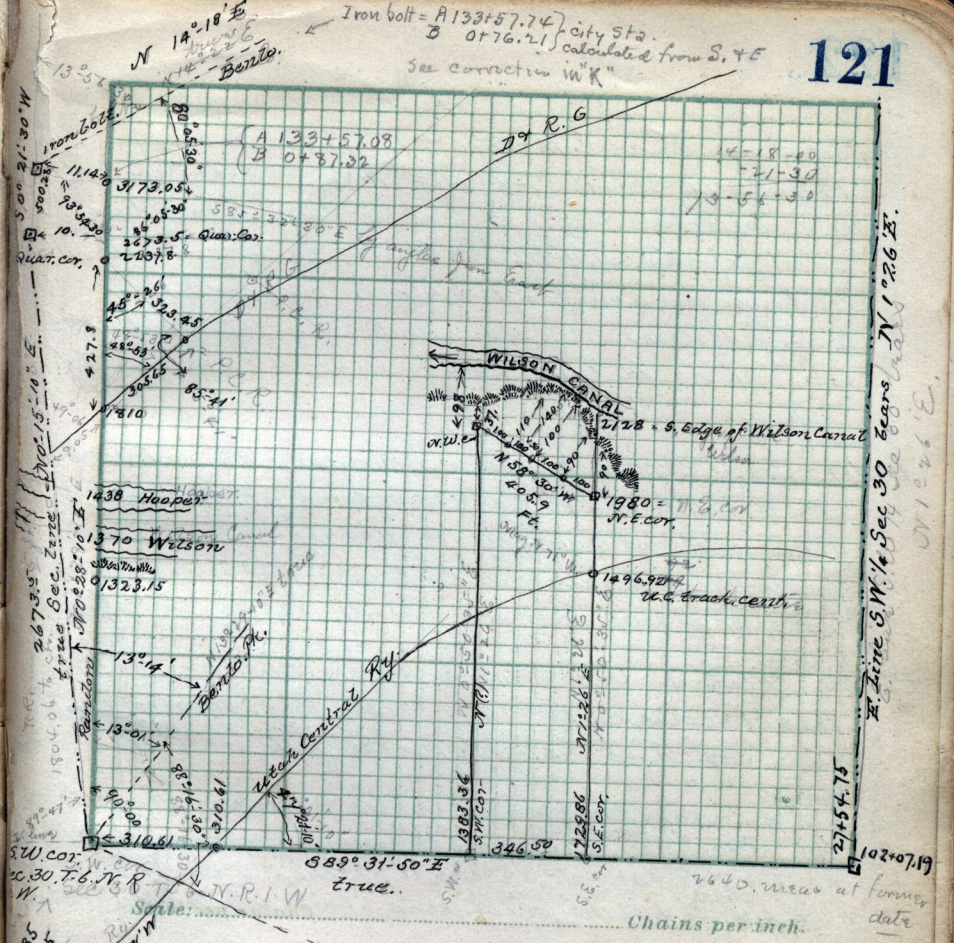

Iron bolt = A 133 + 57.08  
B 0 + 87.02 } city sta.  
calculated from S. & E.  
See correction in 'K'

14-18-40  
-21-30  
13-54-30

E. Line S.W. 1/4 Sec 30 bears N 1° 26' E.  
01126616

N 14° 18' E  
11.14  
3173.05  
3273.5 = Quar. Co.  
2207.8  
48° 26'  
323.45  
306.5  
78.10  
427.8  
1438 Hoopers  
1370 Wilson  
1323.15  
13° 01'  
13° 14'  
85° 41'  
190.6  
310.61  
5. W. cor.  
S. E. cor.  
185  
1804.6  
267.95  
Time Sec. Error  
1902.38 - 10. E  

102+07.19  
27+54.75  
1728.86  
1323.36  
346.50  
1496.90  
1728.86  

N.R.I.W. true  

Chains per inch.  
2640. meas at former date


