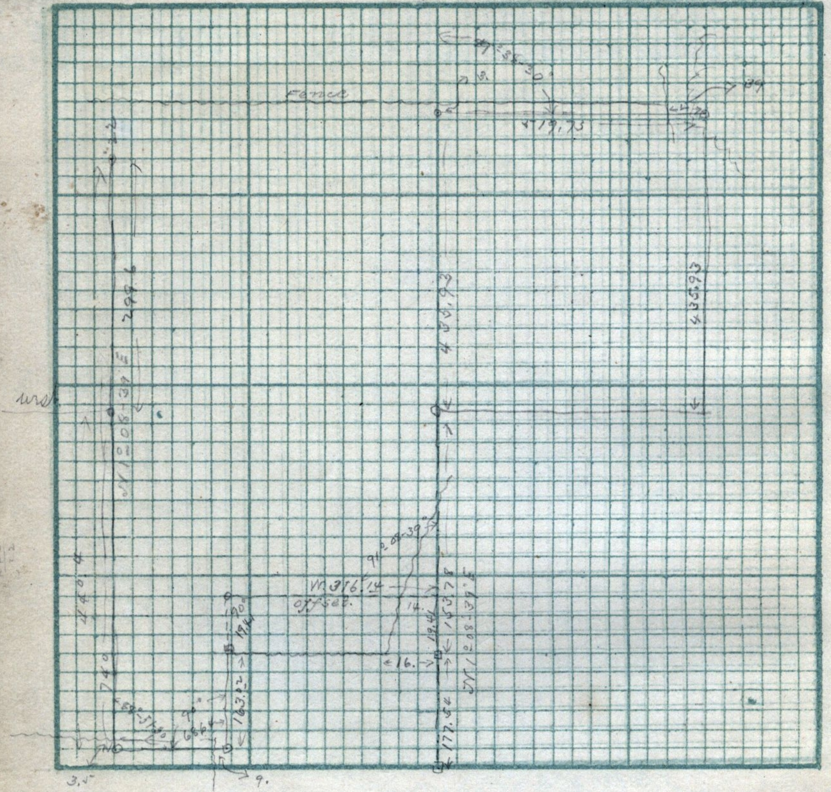

Scale: .... Chains per inch.

July 9 - 1891 - Continuation of Survey for John Barker

I - 238 - Lorin Farr to W. G. Stonehouse. Mar. 12 - 1874
Beg. 3.22 ch W. and 21.75 ch S. from N. E. cor Sec 18 T-6-N. R. 1-W.
W 4.25 ch S 10.85 ch E 5.95 ch N. 7.00 ch. W 1.28 ch N 3.28 ch to beg 5.96 a.

J. 129 Erastus Bingham to W. G. Stonehouse. March 29 - 1875
Beg. 21.75 ch S. and 2.10 ch E. of N. W. cor Sec 17 T-6. N. R. 1-W.
S ¼° W 11.27 ch N 88° W 3.53 ch N 2° W 7.95 ch N 88° E 84/100 of ch S 62½° E .97 ch S 88° E 1.90 ch N 5° E 3.76 ch to beg. 2.80 a.