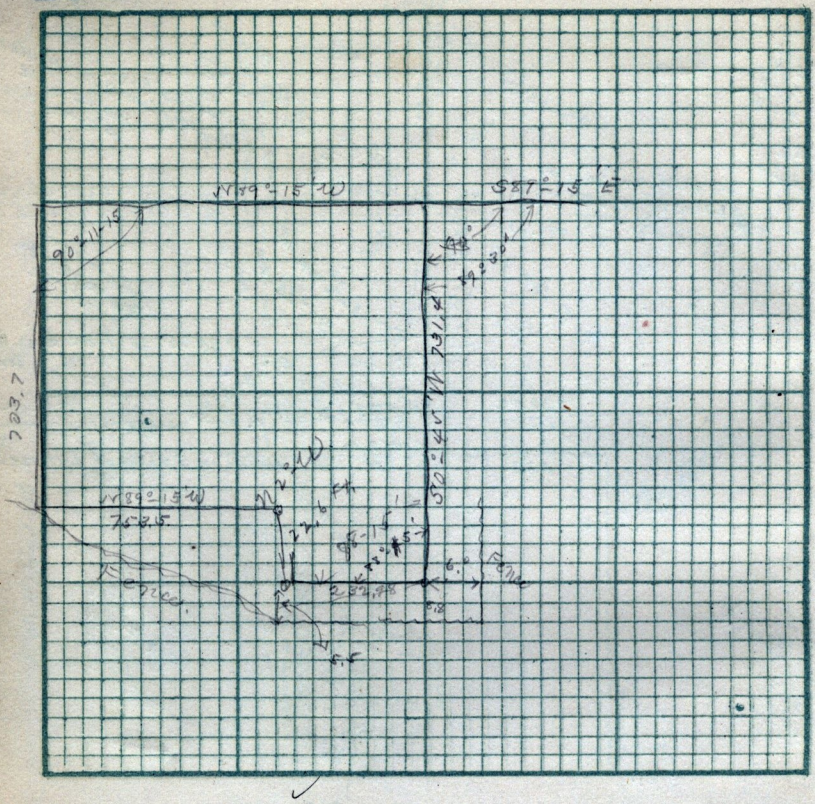

Scale:..... Chains per inch.

Copy of deed from Mr. G. Stowe to Wm A. Lund. Jany 21-1891
Pt of N.E. 1/4 Sec. 18 T-6-N. R.1-W. - Beg. 21.75 ch S. and 12.72 ch W
of N.E. cor of said 1/4 Sec. thence E. 8 rods S 20. rods W. 8 R.
N 20 rods to beg