
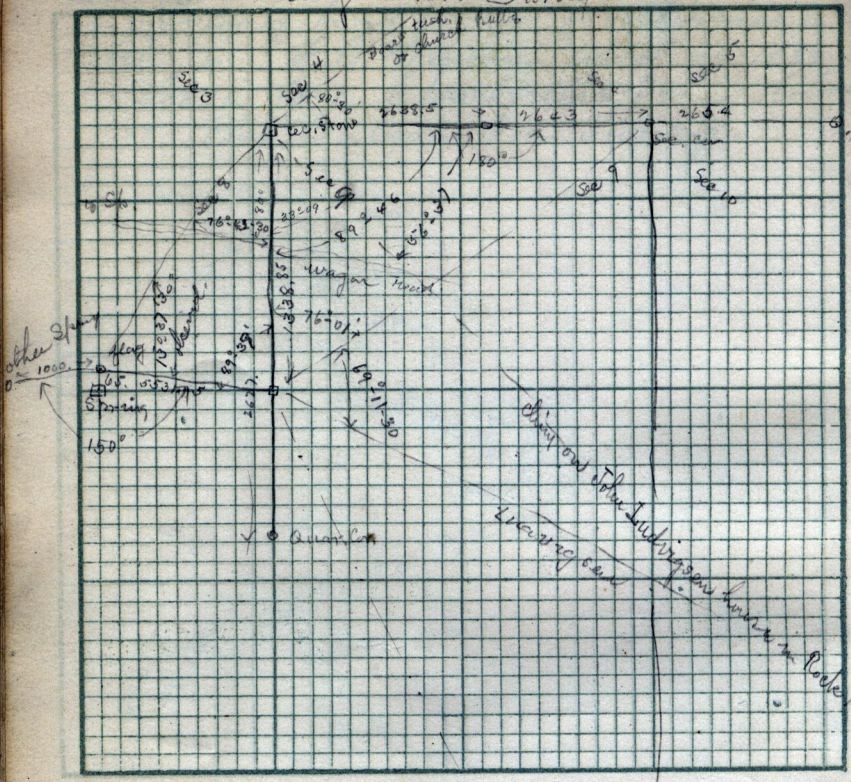
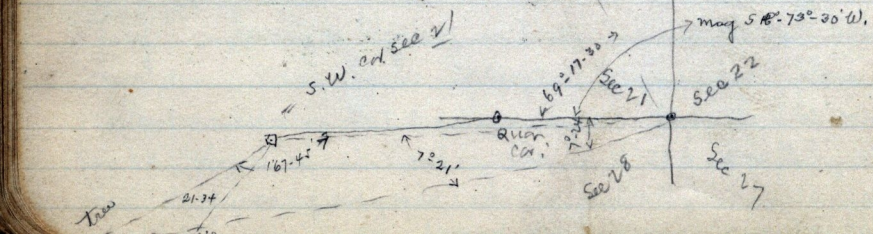
Scale: ..... Chains per inch.