


cont 26<sup>th</sup> St.

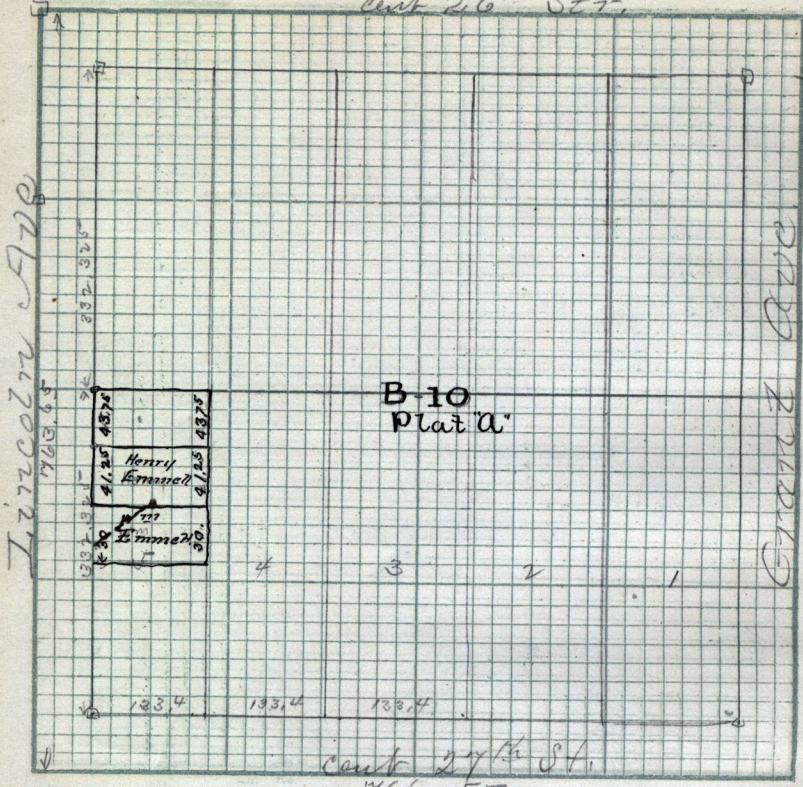

Scale: ..... Chains per inch.

Lot - 5 - Block 10 - Plat "a". Ogden City Survey  
Thomas Emmet.

Sept 2 - 1891

John Layman - J. Baird clay