


Sept 3-1891-

Lincoln Ave

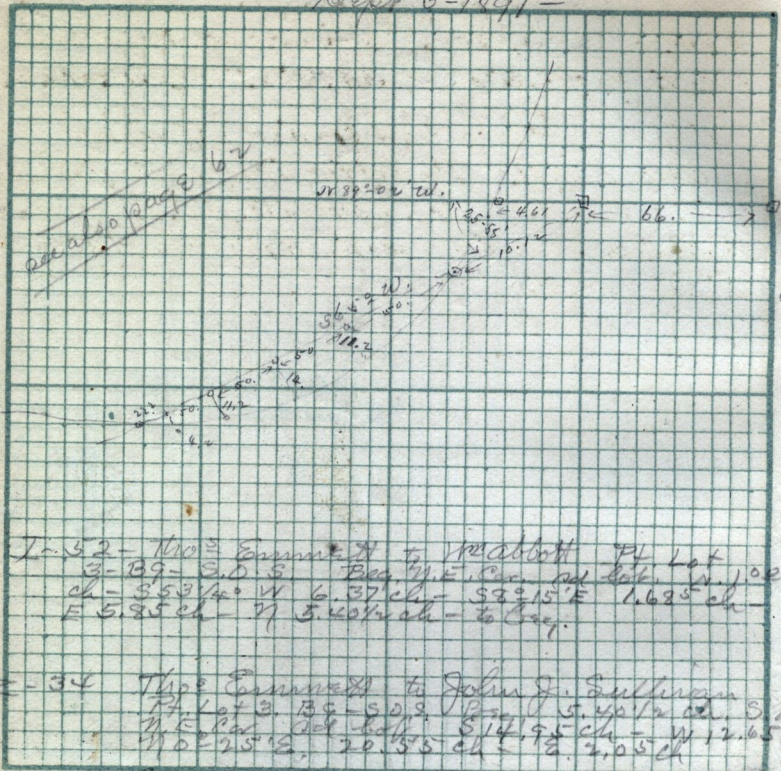


I-32 - Thos E. Emmett to Wm Abbott 74 Lot  
 3-189 - S.D.S. Beg. N.E. 1/4 cor. ad. lot. N. 10° E  
 ch = 3.53 1/2 W 6.37 ch - S 89° 15' E 1.685 ch  
 E 5.85 ch - N 5.40 1/2 ch - to Cor.

I-34 Thos Emmett to John J. Sullivan  
 N.E. 1/4 cor. ad. lot. S 14° 15' E ch - W 12.65  
 N.D. = 25° S, 20.55 ch - S 2.05 ch



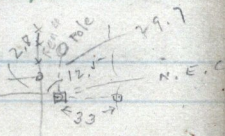

5  
33