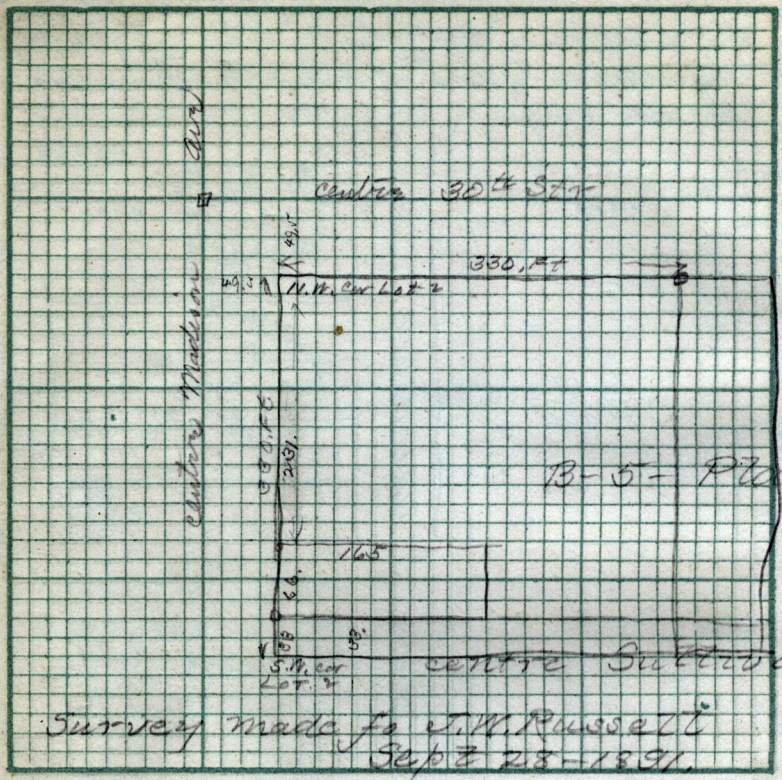

Scale: ..... Chains per inch.

Elizabeth Gibbons, Fanny E. Rackham, Catherine M. Hart Francis J. Gibbons to John Dawson the last described piece of land;
Fanny R. - Francis L. - Thomas - & Wm B. Gibbons to James Gibbons - Beg. 2.50 ch N. of S.E. cor. Lot 10. N 4.45 ch N 24° W. 7.30 ch E. 5.38 ch S 2.10 ch to beg.
Ann C. Gibbons, Elizabeth Allen Evan Evans, and Jannette McKay. to Margaretta P. Evans, as follows;
Beg. N.W. cor of Lot 3. B-4. South Ogden Surv. N 24/100 of a ch