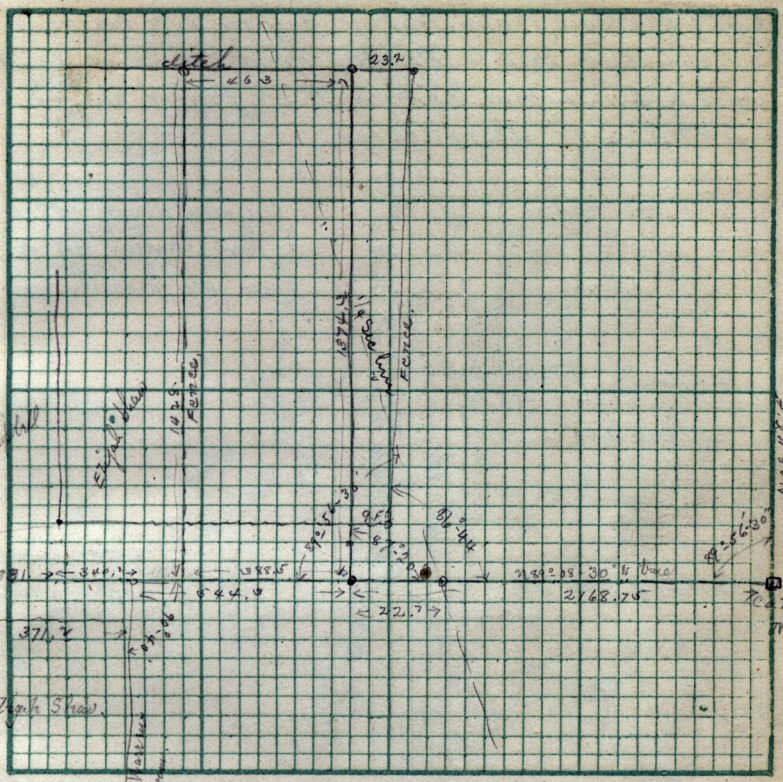
ditch
23.2
46.3
Stake
10.25 Fence
Stake
Stake
Fence
Fence
