Oct 13-1891-

742.5 Ft.

Note - from a point 11.25 chs. South of the N.W. Cor of N.E 1/4 Sec 18 T. 5 N. R. 14 W. O.Bs. Pt. Bears N 72° 30' E. Thus giving the angle made by setting over a post Set on the South Side of R.R. and a Stake cared to be the N. Cor on N. Side of R.R.

- Oct. 15-1894 -

Survey made for W. J. Stevens

in Mountmorris Main St Add.

Chas Pinnock & James Jensen, Laborers

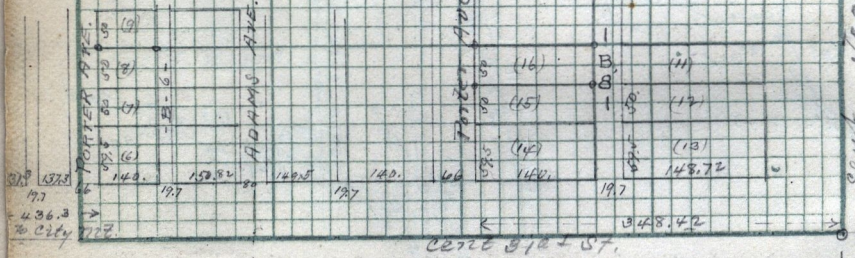

hub. set by Self.

Scale: ..... Chains per inch.