6

Nov 26 - 1891.

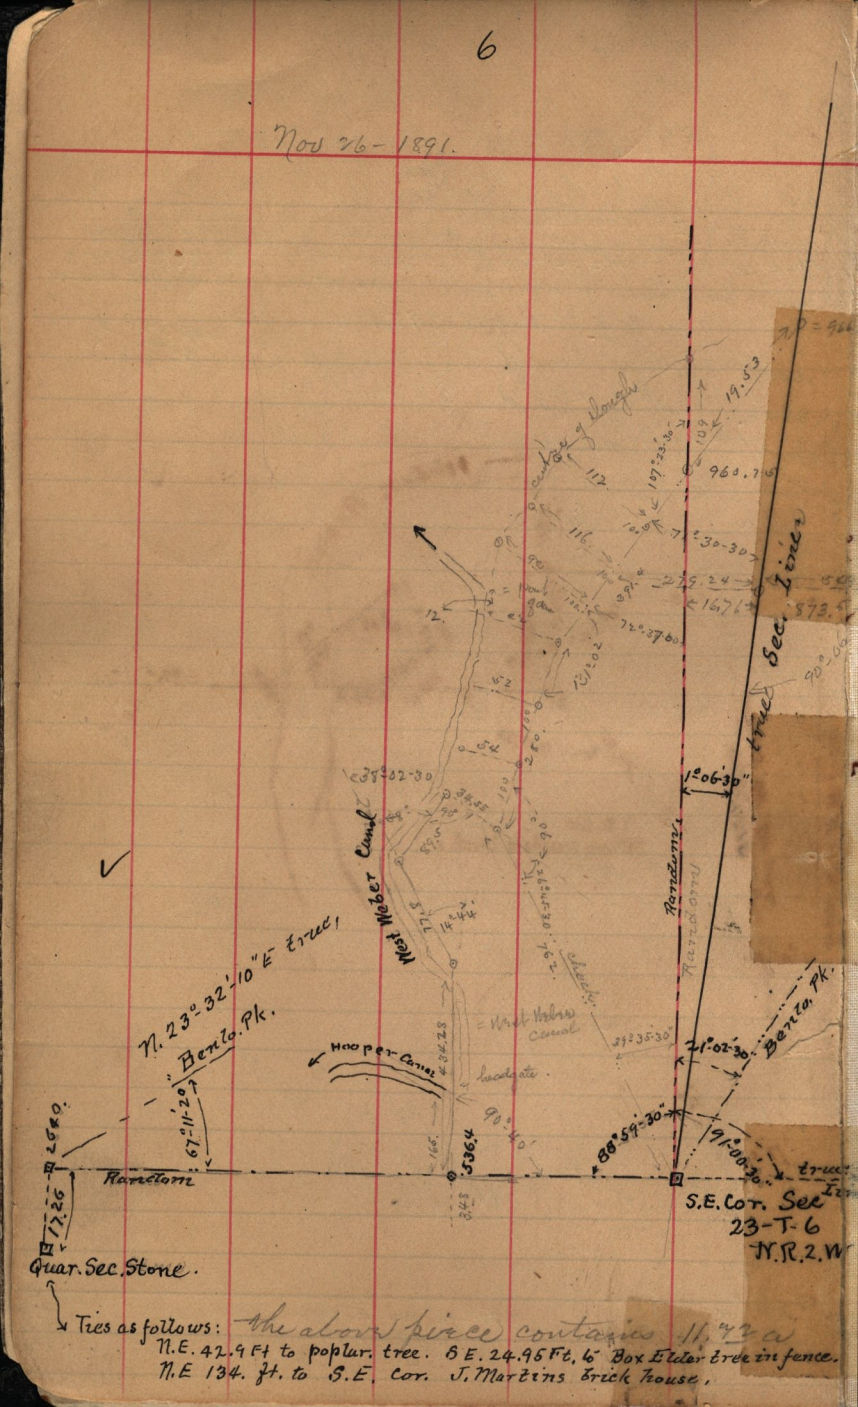

Ties as follows: The above piece contains 11.42 ac
N.E. 42.9 Ft to poplar. tree. S E. 24.95 Ft. 6" Box Elder tree in fence.
N.E 134. ft. to S.E. Cor. J. Martins brick house.