


Dec. 14th 1891.

Survey made in Sec 9 T-5-
N. R. 1-W. for Philip Garner,
Layman & Baird Chairman

Land to be conveyed by
Philip Garner to Rudolph Van Dyke

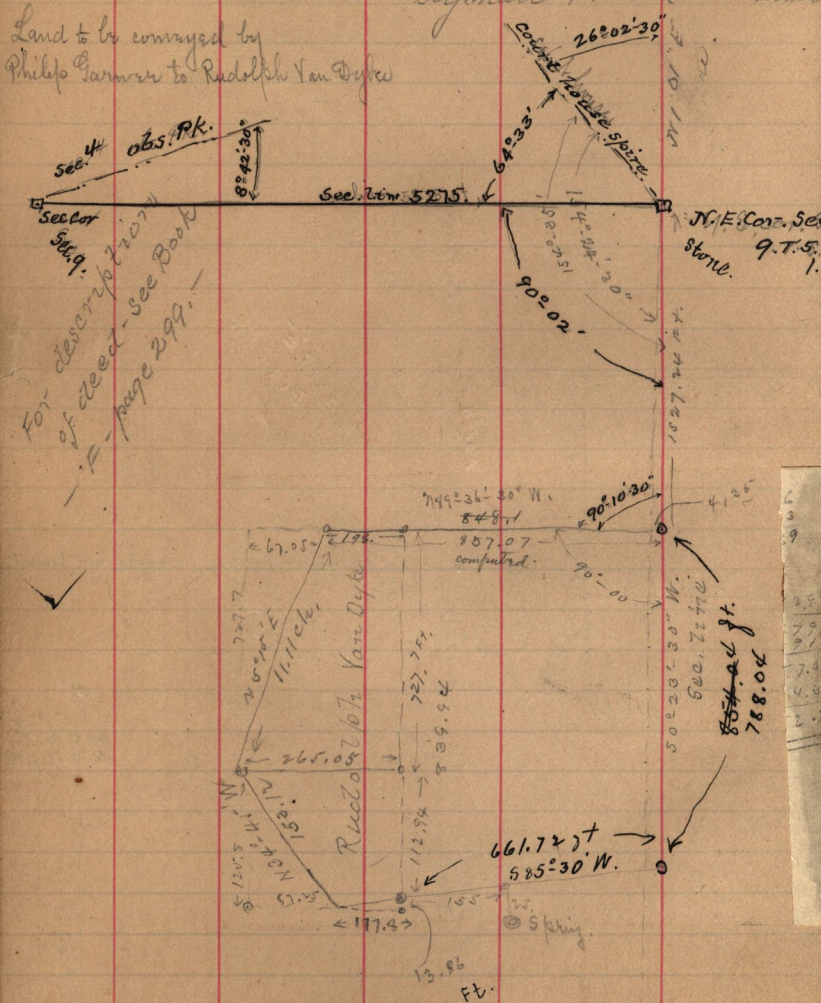

The right to use the water in a certain Spring adjacent
155. ft E. & 25 ft S. of the S.E. corner of the tract.