


Survey of Sec. 10-T. 5. N. R. 2. W. by Schuyler.

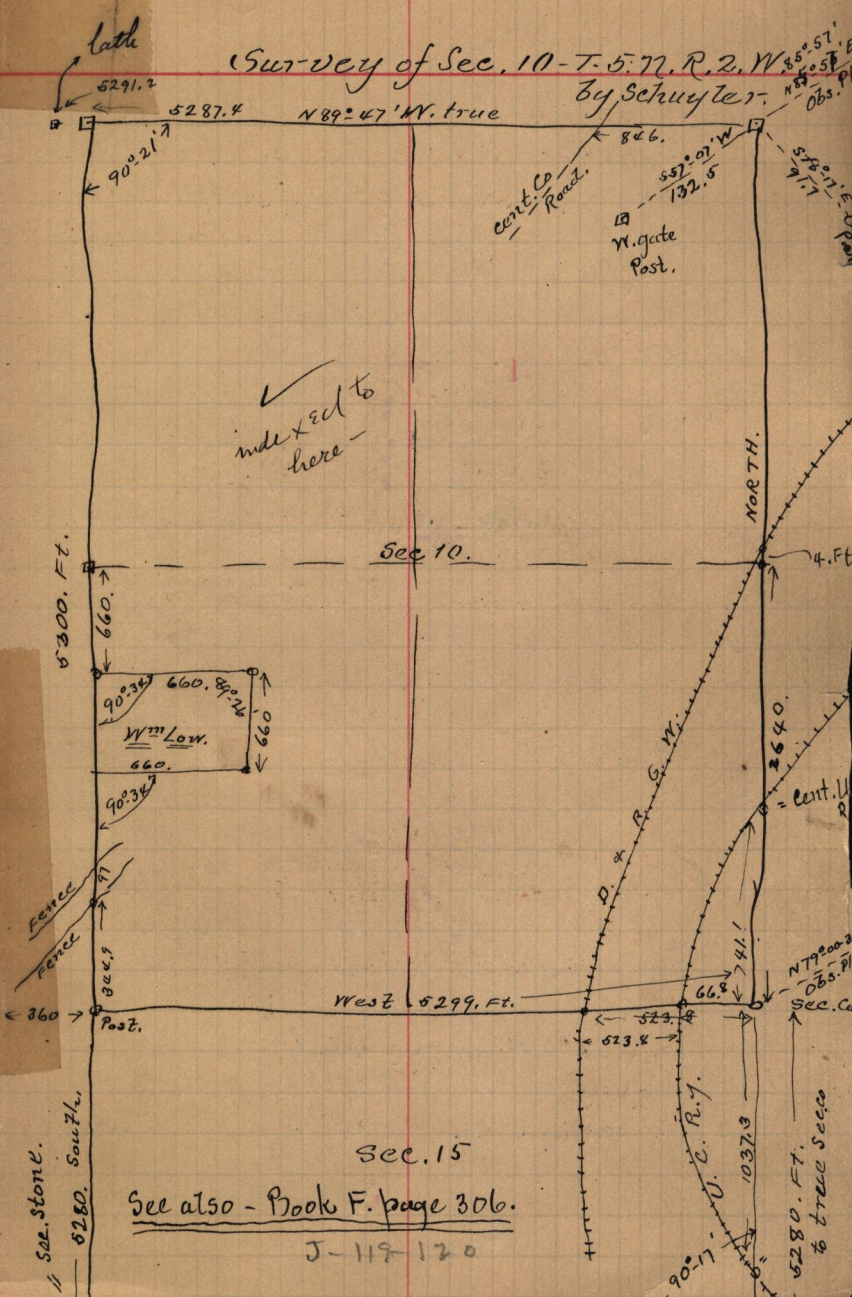

indexed to here

Sec 10.

NORTH

Wm Low

Sec. 15

See also - Book F. page 306.

J-119-120

See Stone.

6280. South.

N 79^{\circ} 00' 30" Obs. Pk

Sec. Cor

5280. Ft. to tree Secs