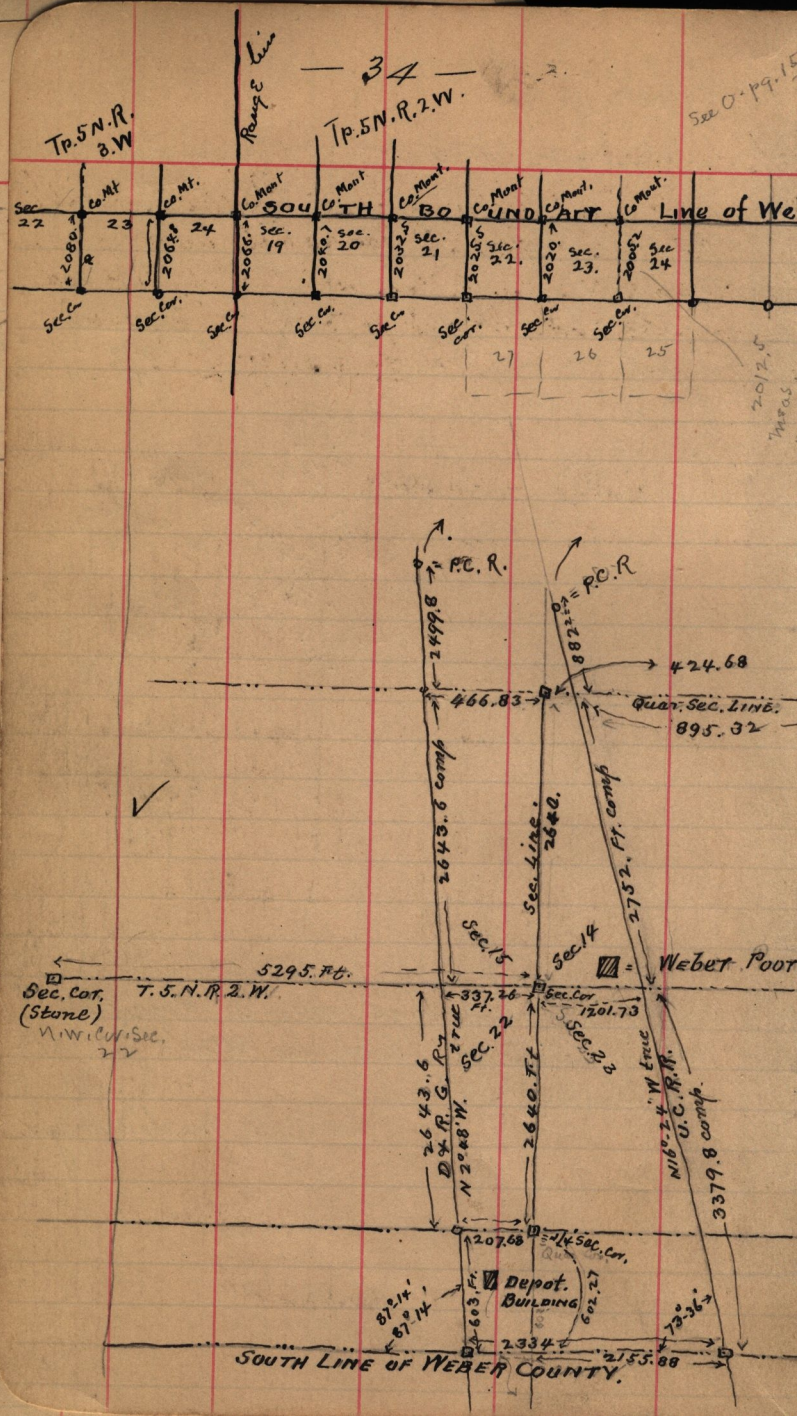
Range Line
Tp. 5 N. R. 3. W
Tp. 5 N. R. 2. W.
Co. Mt
Co. Mont
Sec. 22
23
24
Sec. 19
Sec. 20
Sec. 21
Sec. 22.
Sec. 23.
Sec. 24
SOUTH BOUNDARY Line of We
Sec. Cor.
27
26
25
P.C.R.
2499.8
2643.6 comp
466.83
882.2
424.68
Quar. Sec. Line.
895.32
Sec. Line.
2640.
2752. Ft. comp
Sec. 15
Sec. 14
Weber Poor
5295. Ft.
Sec. Cor. (Stone)
T. 5. N. R. 2. W.
N.W. Cor. Sec. 22
337.26 Ft.
Sec. Cor.
1201.73
Sec. 22
Sec. 23
2643.6
D & R. G. R.
N 2° 48' W. true
2640. Ft.
N 16° 24' W true
U.C. R.R.
3379.8 comp.
207.68
Sec. Cor.
Depot. Building
87° 14'
87° 14'
603. Ft.
602.27
73° 36'
2334
2155.88
SOUTH LINE OF WEBER COUNTY.